SW 14 29 23

Certificate of Survey

From the office of

GEORGI- SCHMIDT & ASSOC. INC.

3092 No. Lexington Ave., Roseville, Mn. 55113

LAND SURVEYING

483-4408

I Hereby Certify that this plat shows a survey made by me of the property described on this plat, and that the corners are correctly placed as shown, and that all locations have been correctly shown.

Job Number: 622

Surveyed For Mike Cregan

Date May 2, 1980

Scale 1"=40'

By Donald W. Schmidt
REGISTERED LAND SURVEYOR

Description:
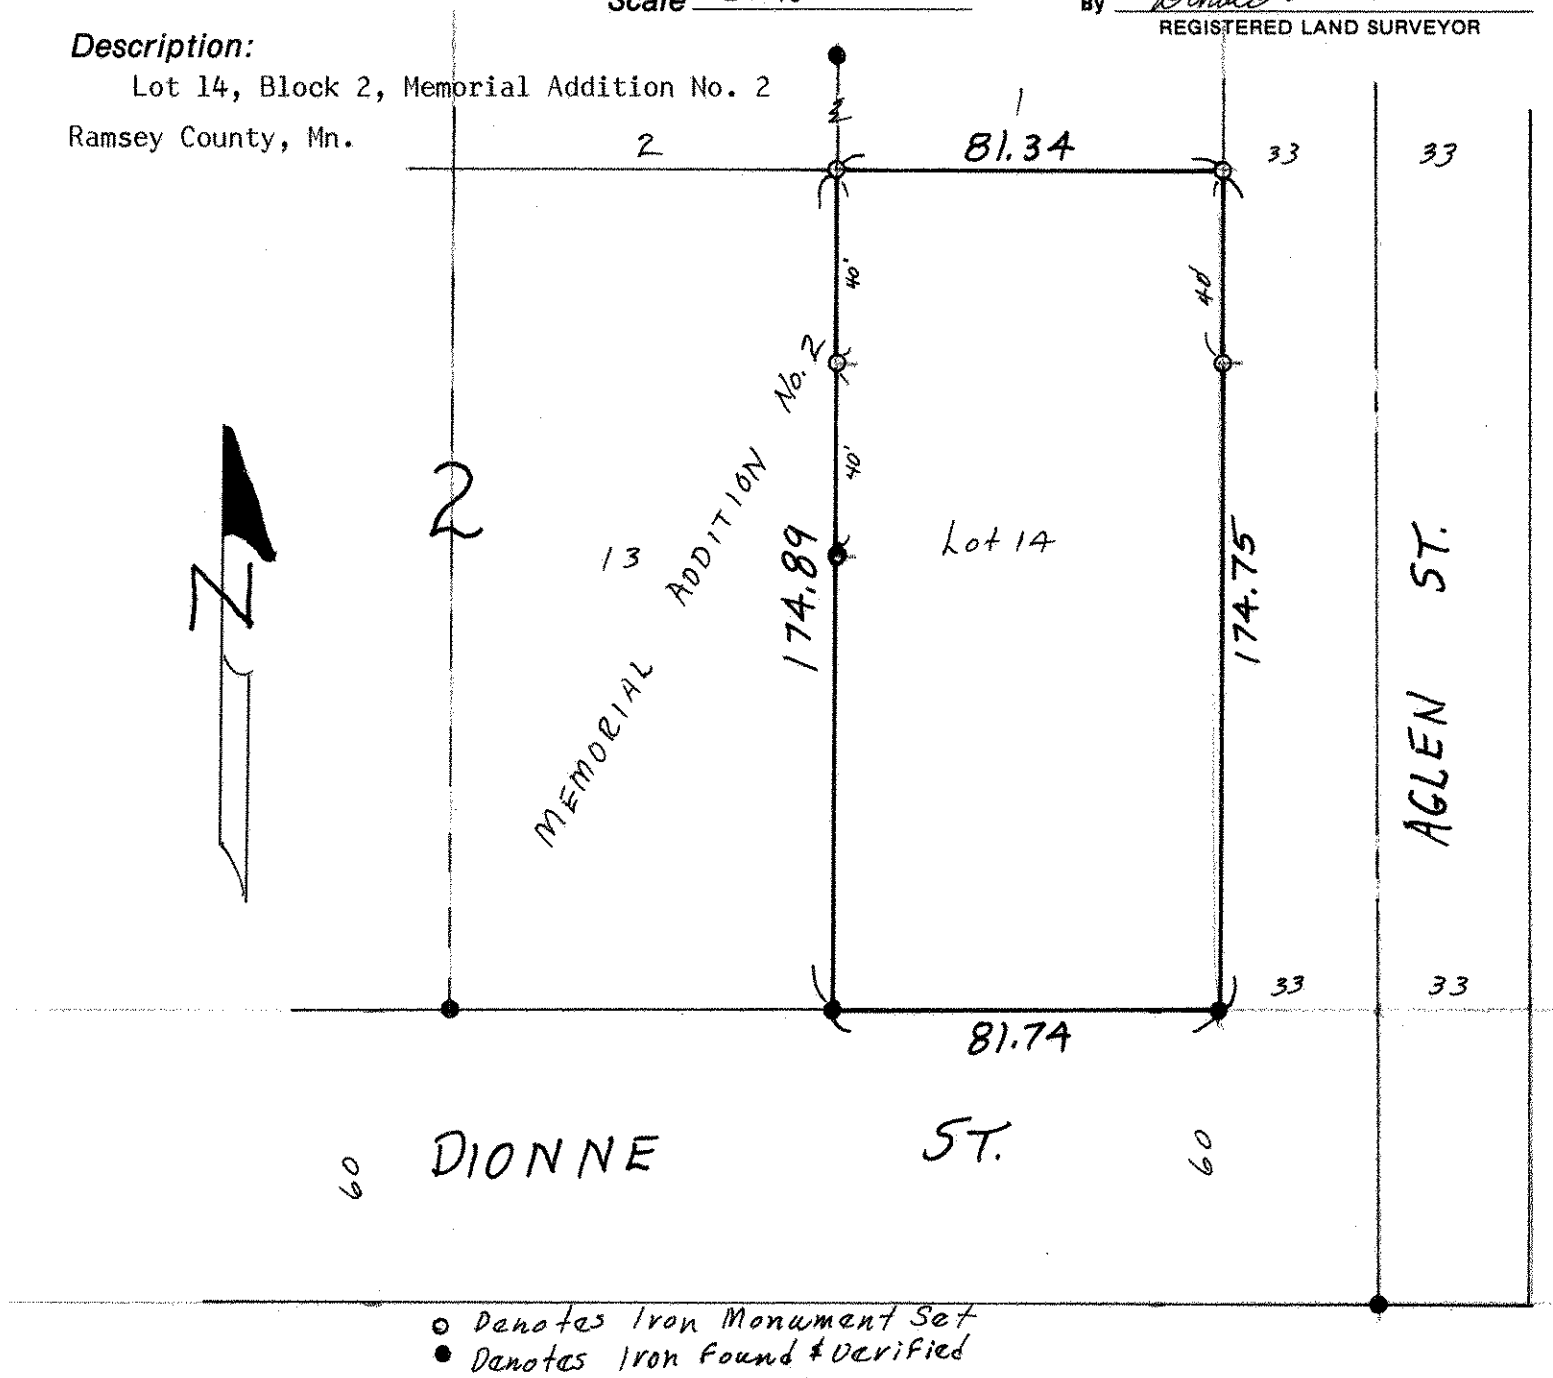
Lot 14, Block 2, Memorial Addition No. 2
Ramsey County, Mn.