

Certificate of Survey

From the office of
GEORGI-SCHMIDT & ASSOC. INC.

3092 No. Lexington Ave., Roseville, Mn. 55113

LAND SURVEYING

483-4408

I Hereby Certify that this plat shows a survey made by me of the property described on this plat, and that the corners are correctly placed as shown, and that all locations have been correctly shown.

Job Number: 584

Surveyed For Sonnen Brothers Const

Date Feb 27, 1980

Scale 1" = 40'

By Donald W. Schmidt
REGISTERED LAND SURVEYOR


Description:

Lot 51, Block 7

Burlington Heights #2

Ramsey County, Minnesota.

60 BURLINGTON ROAD 60

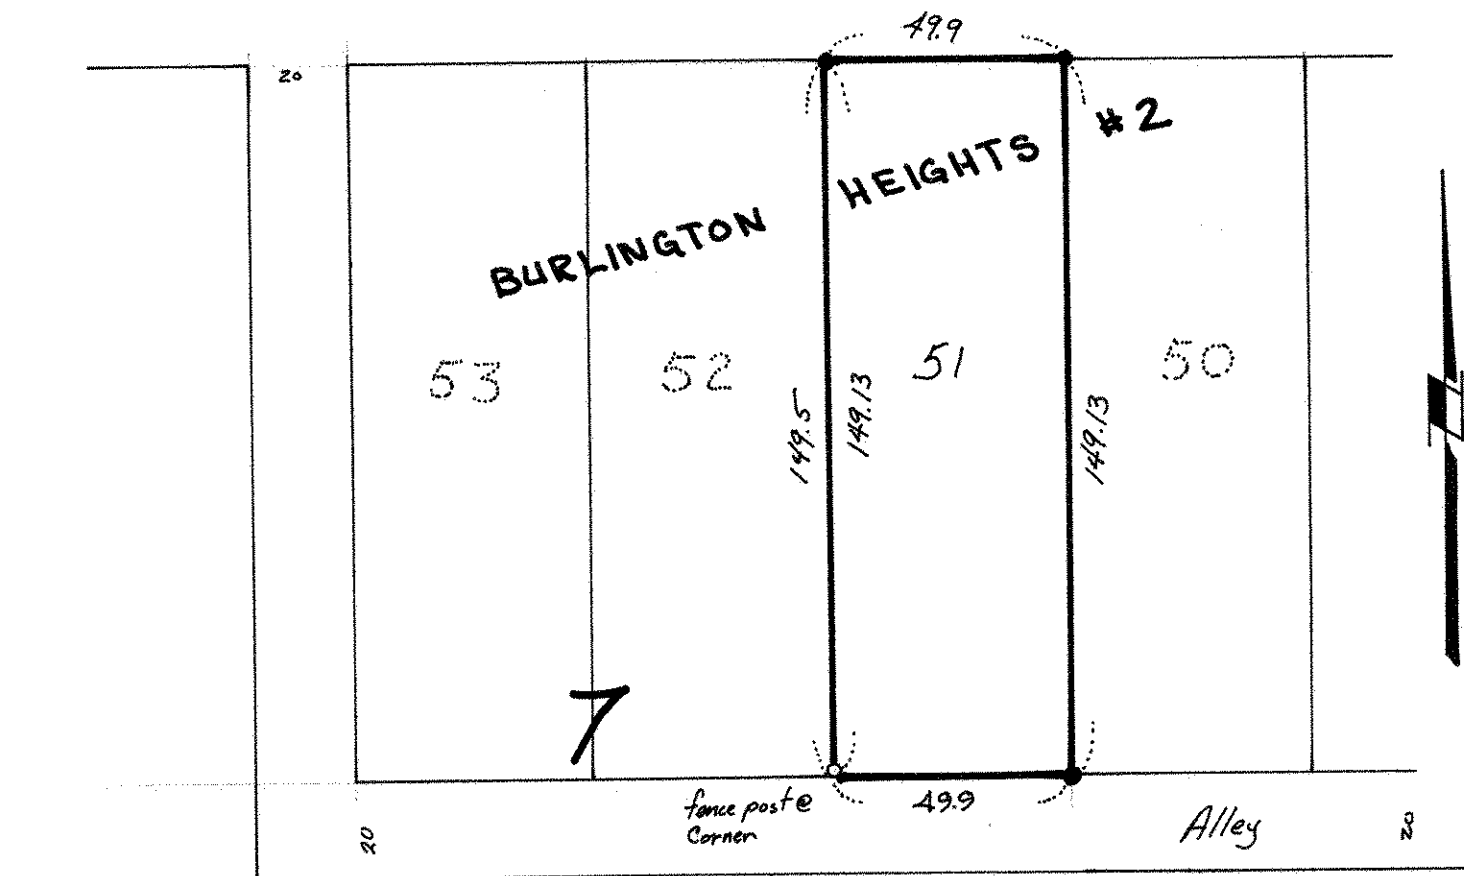

● Denotes iron pipe monument found in place

○ Denotes iron pipe monument