

Certificate of Survey

From the office of
GEORGI-SCHMIDT & ASSOC. INC.
3092 No. Lexington Ave., Roseville, Mn. 55113
LAND SURVEYING
483-4408

I Hereby Certify that this plat shows a survey made by me of the property described on this plat, and that the corners are correctly placed as shown, and that all locations have been correctly shown.

Job Number: 669


Surveyed For Sonnen Brothers Cons't

Date June 23, 1980

Scale 1" = 40'

By Donald Schmidt
REGISTERED LAND SURVEYOR

Description:
Lot 19 & the East 10.0 feet of Lot 20
Block 1 Bizonz Swiss Meadows,
Ramsey County, Minnesota.

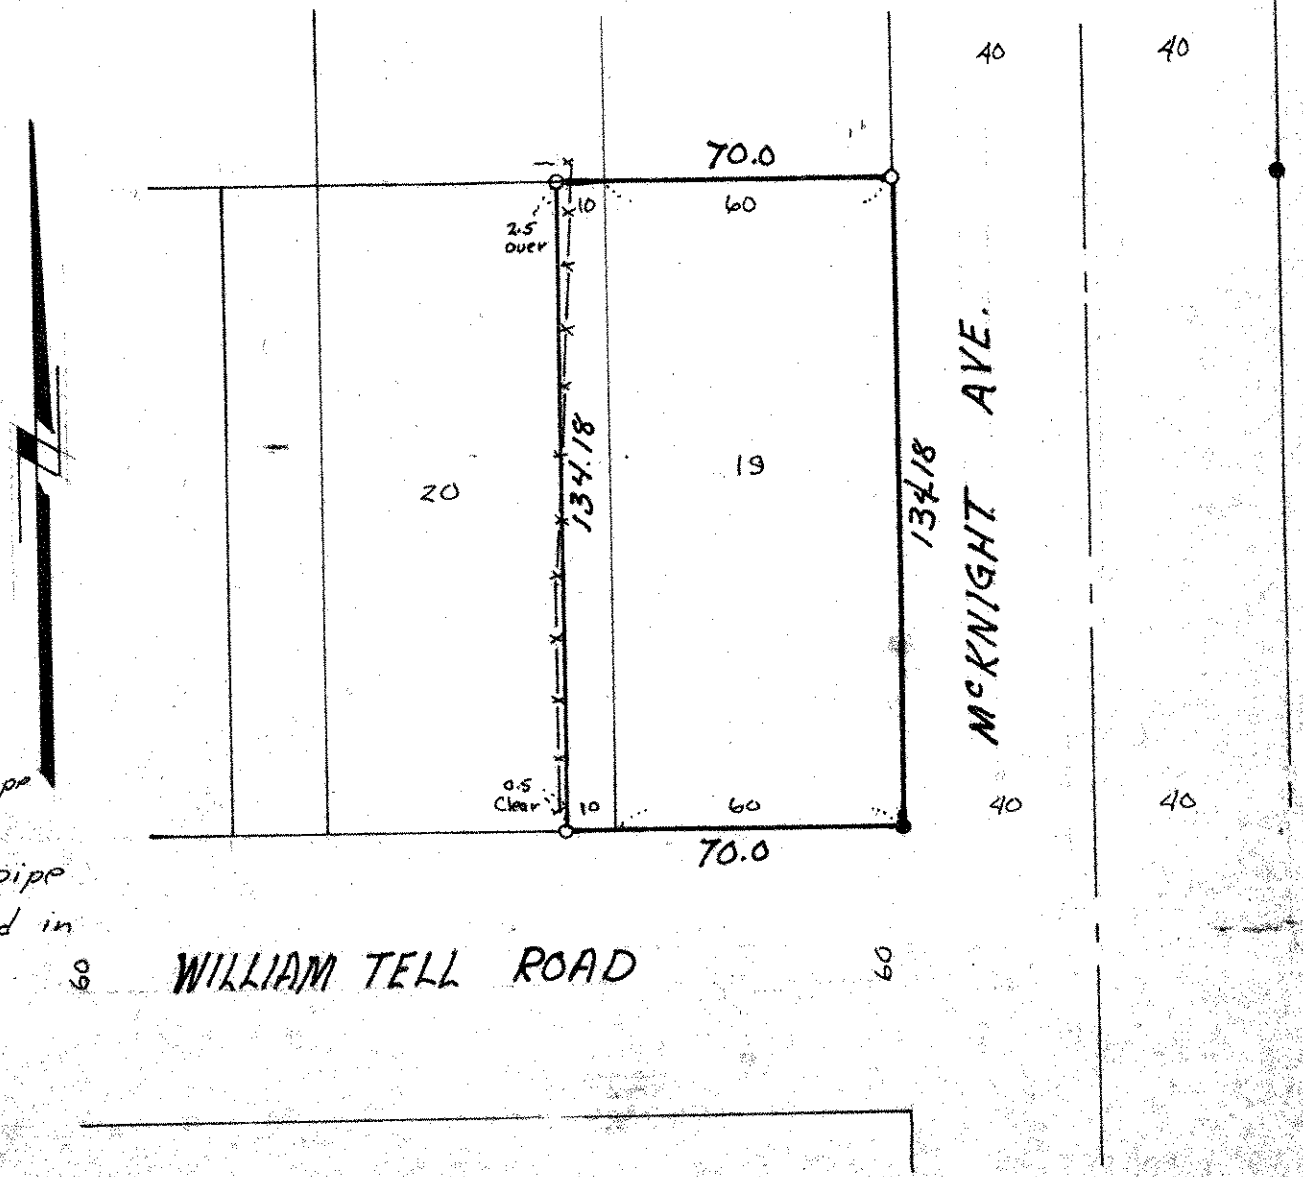

o Denotes iron pipe monument
● Denotes iron pipe monument found in place