SW 2 29 23

Certificate of Survey

From the office of

GEORGI- SCHMIDT & ASSOC. INC.

3092 No. Lexington Ave., Roseville, Mn. 55113

LAND SURVEYING

483-4408

I Hereby Certify that this plat shows a survey made by me of the property described on this plat, and that the corners are correctly placed as shown, and that all locations have been correctly shown.

Job Number: 1001

Surveyed For Douglas Murray

Date 7/20/81

Scale 1"=60'

By Donald W. Schmidt

REGISTERED LAND SURVEYOR

Description:

The South 101.59 feet of the West 140 feet of the East 276.3 feet of the North 134.59 feet of the East 1/2 of the West 1/2 of the SW 1/4 of Section 2, T29N, R23W.

Ramsey County, Minnesota

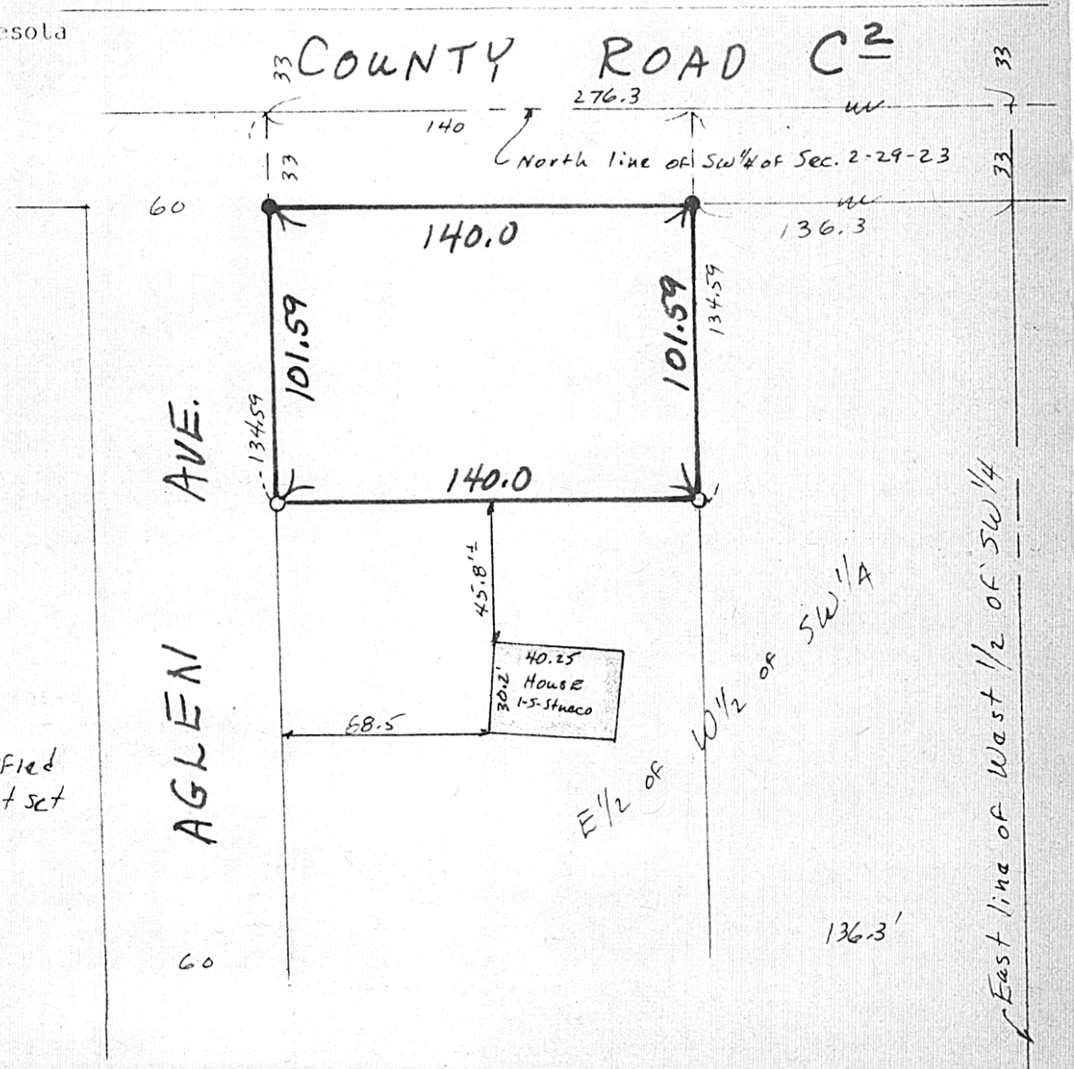

● Denotes Iron Found inplace & Verified

○ Denotes Iron Pipe Monument set