SW 33 30 23

Certificate of Survey

From the office of

GEORGI- SCHMIDT & ASSOC. INC.

3092 No. Lexington Ave., Roseville, Mn. 55113

LAND SURVEYING

483-4408

I Hereby Certify that this plat shows a survey made by me of the property described on this plat, and that the corners are correctly placed as shown, and that all locations have been correctly shown.

Job Number: 984

Surveyed For Joal Addison

Date June 1981

Scale 1" = 40'

By Gerald W. Schmidt
REGISTERED LAND SURVEYOR

Description: (non-furnished): the South 290.75 feet of the West 80 feet of the East 539.8 feet of the NW¼ of the SW¼ of Section 33, T.30, R.23 Ramsey County, Minnesota.
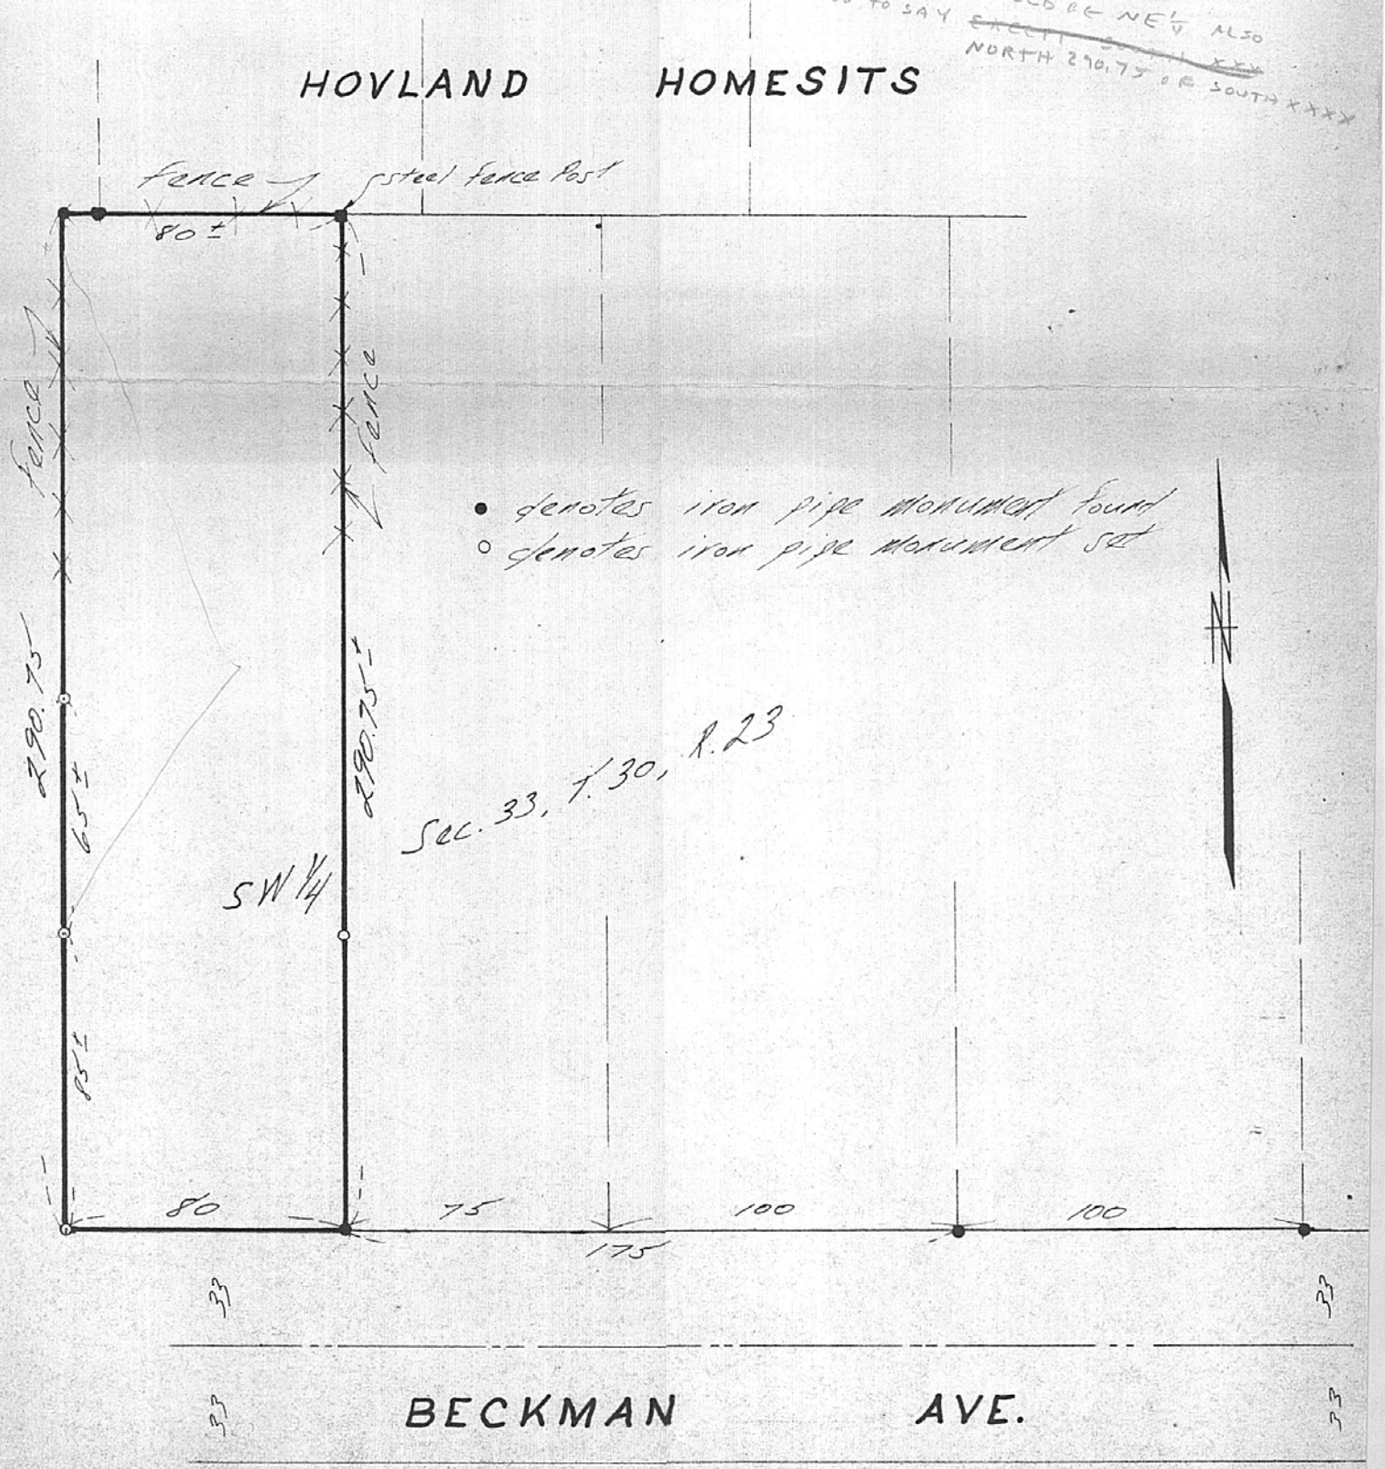
THIS DESCRIPTION LOOKS BAD
PLAT BOOK SCALES 571.8 EAST
ALSO NW¼ SHOULD BE NE¼ ALSO
NEED TO SAY ~~EXCEPT~~ NORTH 290.75' OR SOUTH ++++