

NW 36 30 23

Certificate of Survey

From the office of GEORGI-SCHMIDT & ASSOC. INC.

3092 No. Lexington Ave., Roseville, Mn. 55113

LAND SURVEYING

483-4408

I Hereby Certify that this plat shows a survey made by me of the property described on this plat, and that the corners are correctly placed as shown, and that all locations have been correctly shown.

Job Number: 905

Surveyed For Oh-Ho Bldg's


Date APRIL 1981

Scale 1" = 40'

By Donald W. Schmidt
REGISTERED LAND SURVEYOR

Description:

Lot 14, Block 1
Lakeshore Oaks Addition No. 2
Ramsey County, Minn.

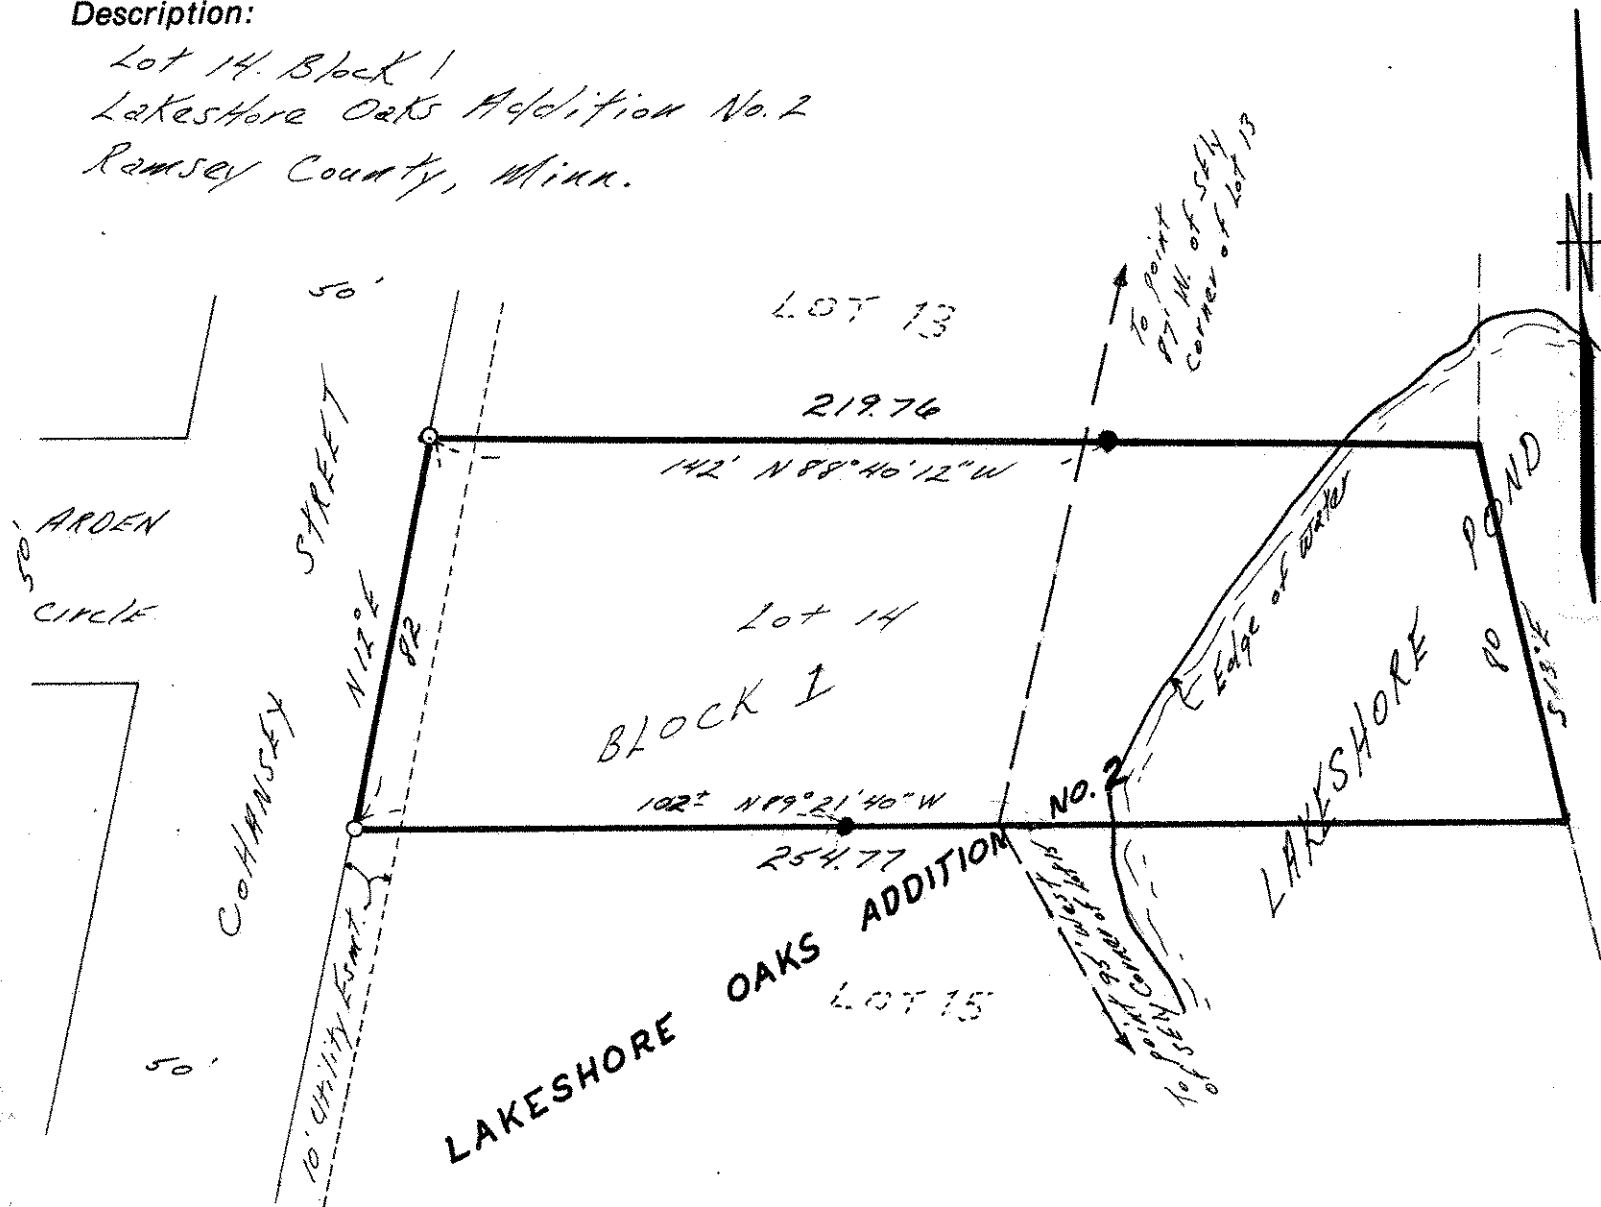

- Denotes Iron Pipe Monument Found
- Denotes Iron Pipe Monument Set