

**Certificate
of Survey**

From the office of
GEORGI-SCHMIDT & ASSOC. INC.
3092 No. Lexington Ave., Roseville, Mn. 55113
LAND SURVEYING
483-4408

I Hereby Certify that this plat shows a survey made by me of the property described on this plat, and that the corners are correctly placed as shown, and that all locations have been correctly shown.

Job Number: _____

Surveyed For Ray Kroiss


Date December 18 1981

Scale 1" = 60'

By Donald W. Schmitt
REGISTERED LAND SURVEYOR

Description:

Lot 10,
Block 1,
Lakeshore Oaks Addition,
Ramsey County, Minnesota

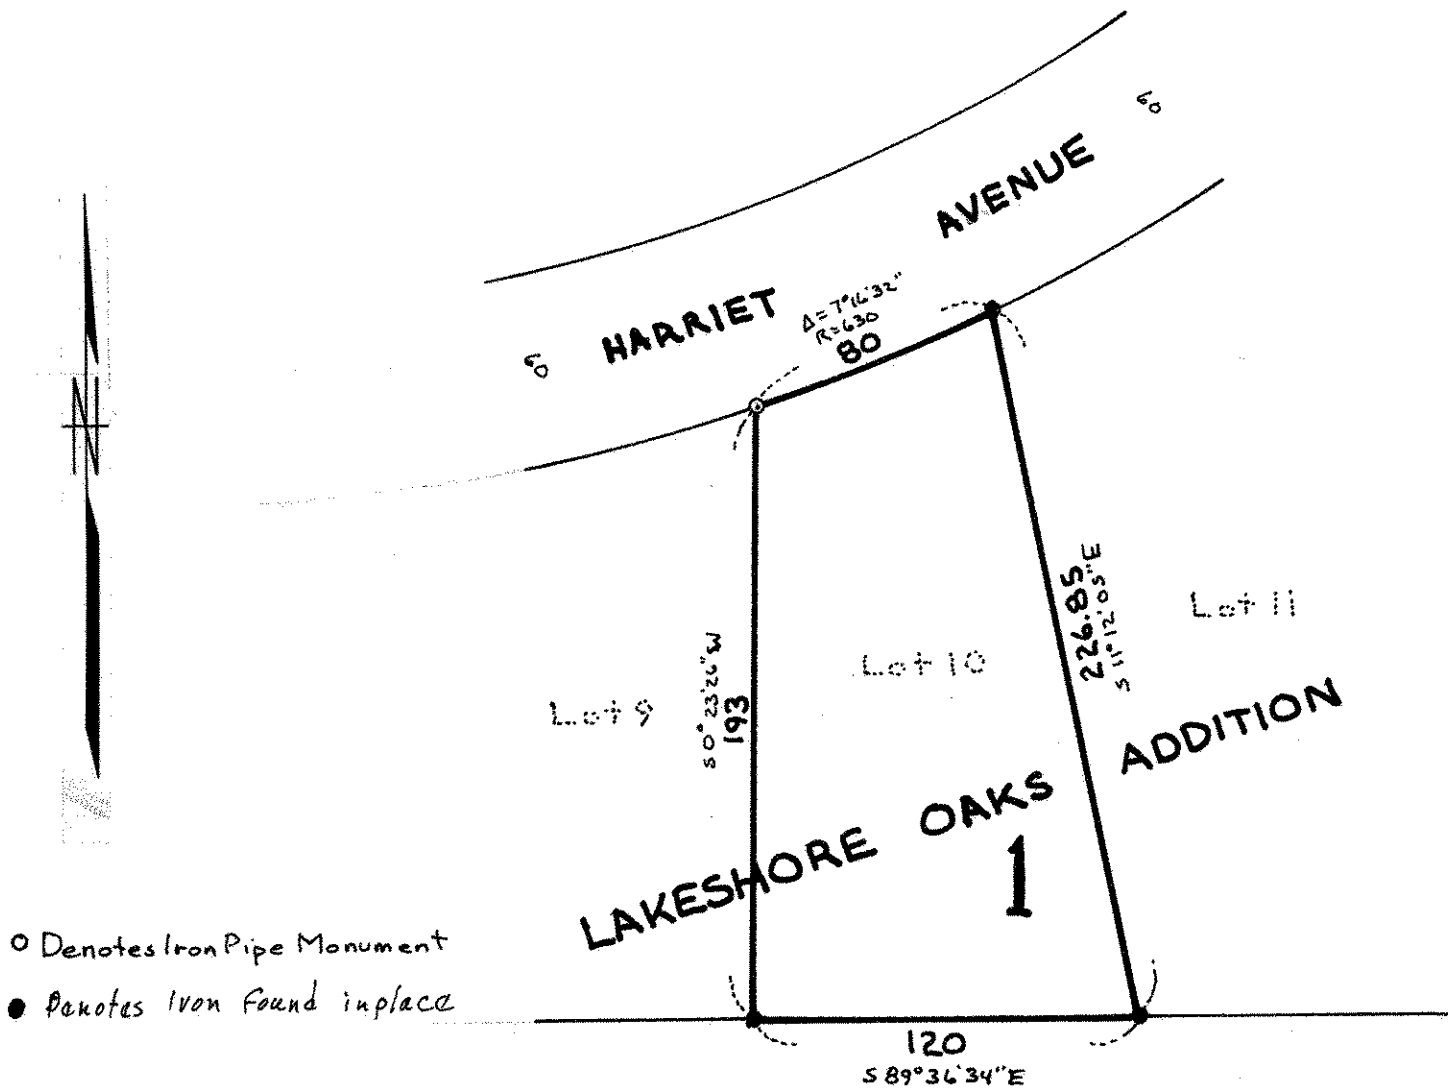

○ Denotes Iron Pipe Monument
● Denotes Iron Found in place