NE 23 29 22

Certificate of Survey

From the office of

GEORGI- SCHMIDT & ASSOC. INC.

3092 No. Lexington Ave., Roseville, Mn. 55113

LAND SURVEYING

483-4408

I Hereby Certify that this plat shows a survey made by me of the property described on this plat, and ~~that the corners are correctly placed as shown,~~ and that all locations have been correctly shown.

Job Number: 1062

Surveyed For Hughes Const

Date 10/5/81

Scale 1" = 50'

By Donald W. Schmidt

REGISTERED LAND SURVEYOR

Description:

Lot 1, Block 12, except the East 75 feet and the South 100 feet thereof, Furness Garden Lots.
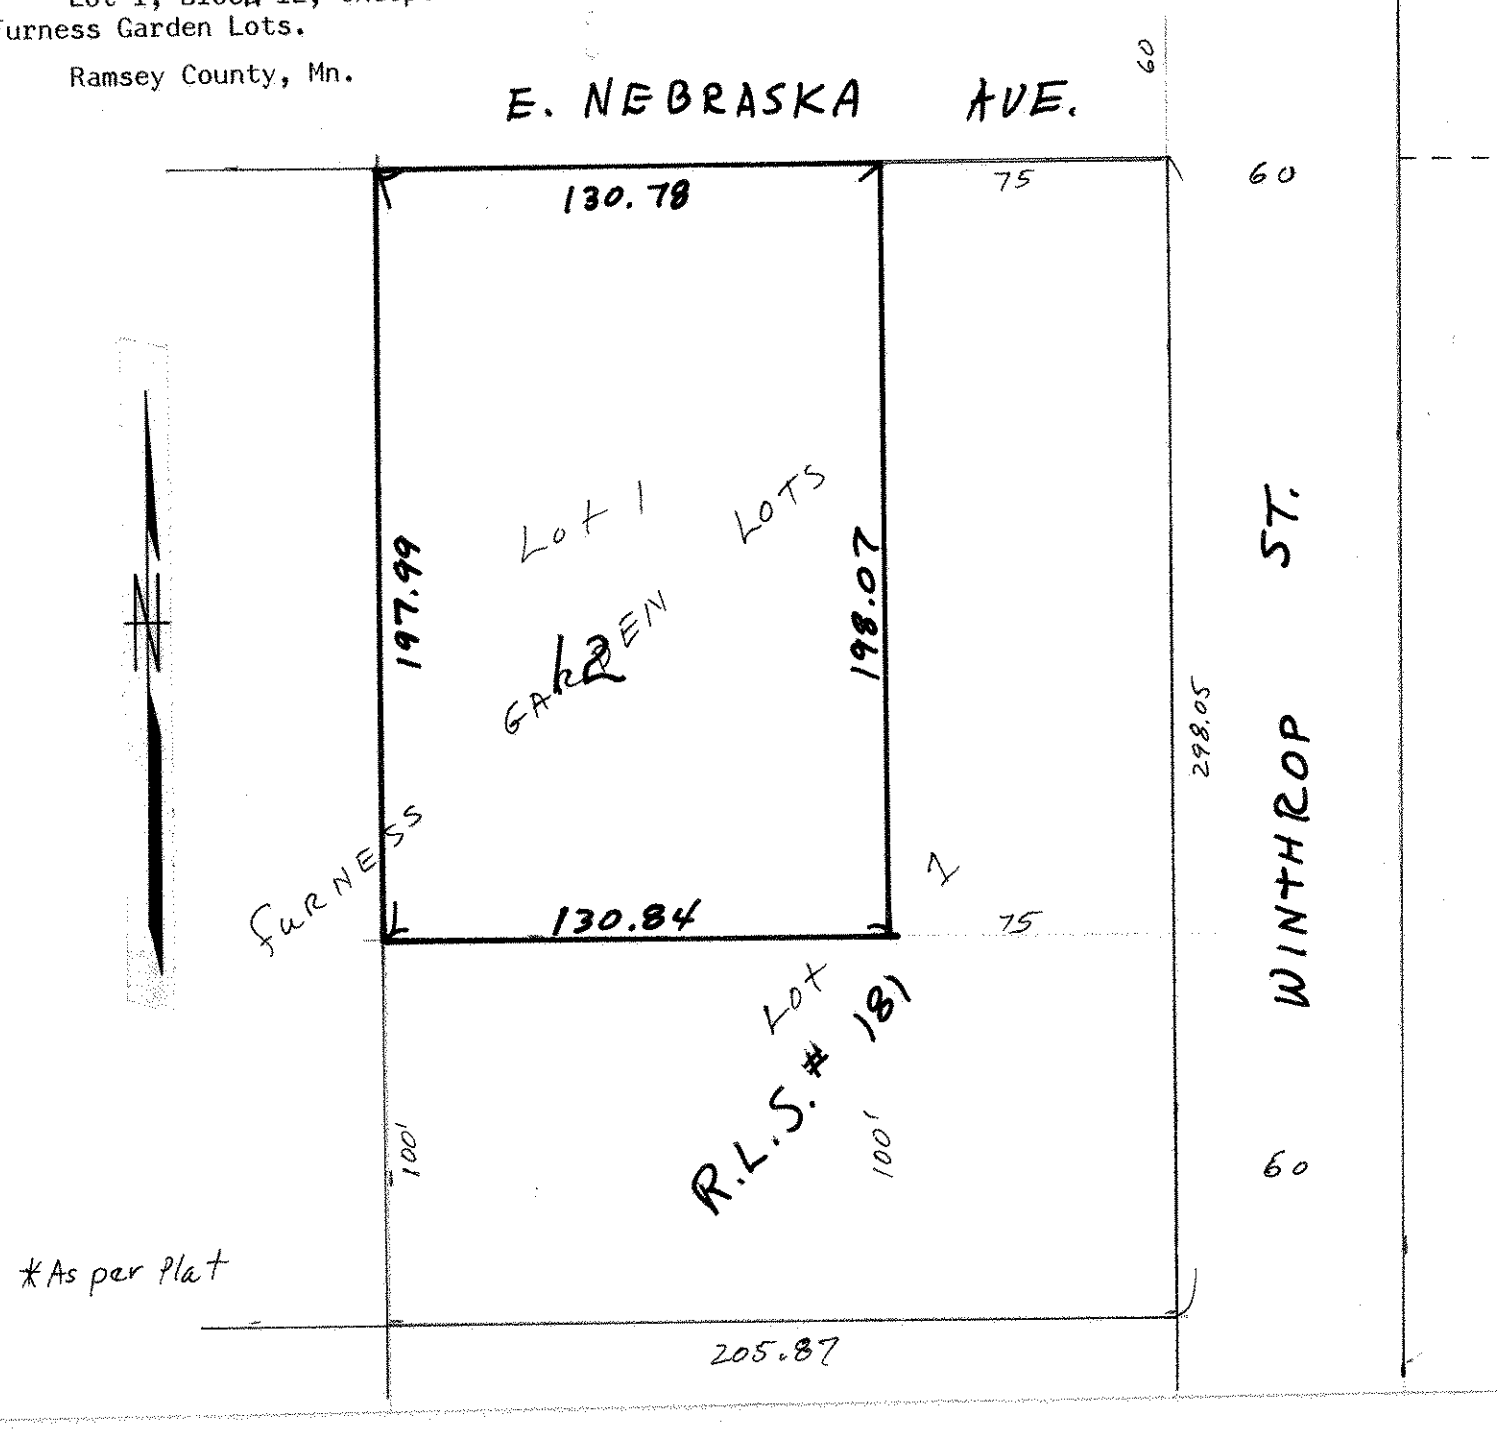
Ramsey County, Mn.