Certificate of Survey

From the office of

GEORGI- SCHMIDT & ASSOC. INC.

3092 No. Lexington Ave., Roseville, Mn. 55113
LAND SURVEYING
483-4408

I Hereby Certify that this plat shows a survey made by me of the property described on this plat, ~~and that the corners are correctly placed as shown~~, and that all locations have been correctly shown.

Job Number: 885
Surveyed For James Sweeney
Date 3/17/81
Scale 1"= 40'

By Gerald W. Schmidt
REGISTERED LAND SURVEYOR

DESCRIPTION:

That part of Lot 16, Asylum Outlots lying West of Water Works Right-of-way and the East 1/2 of adjoining vacated St. Albans Street. Subject to a 40 foot sewer easement.
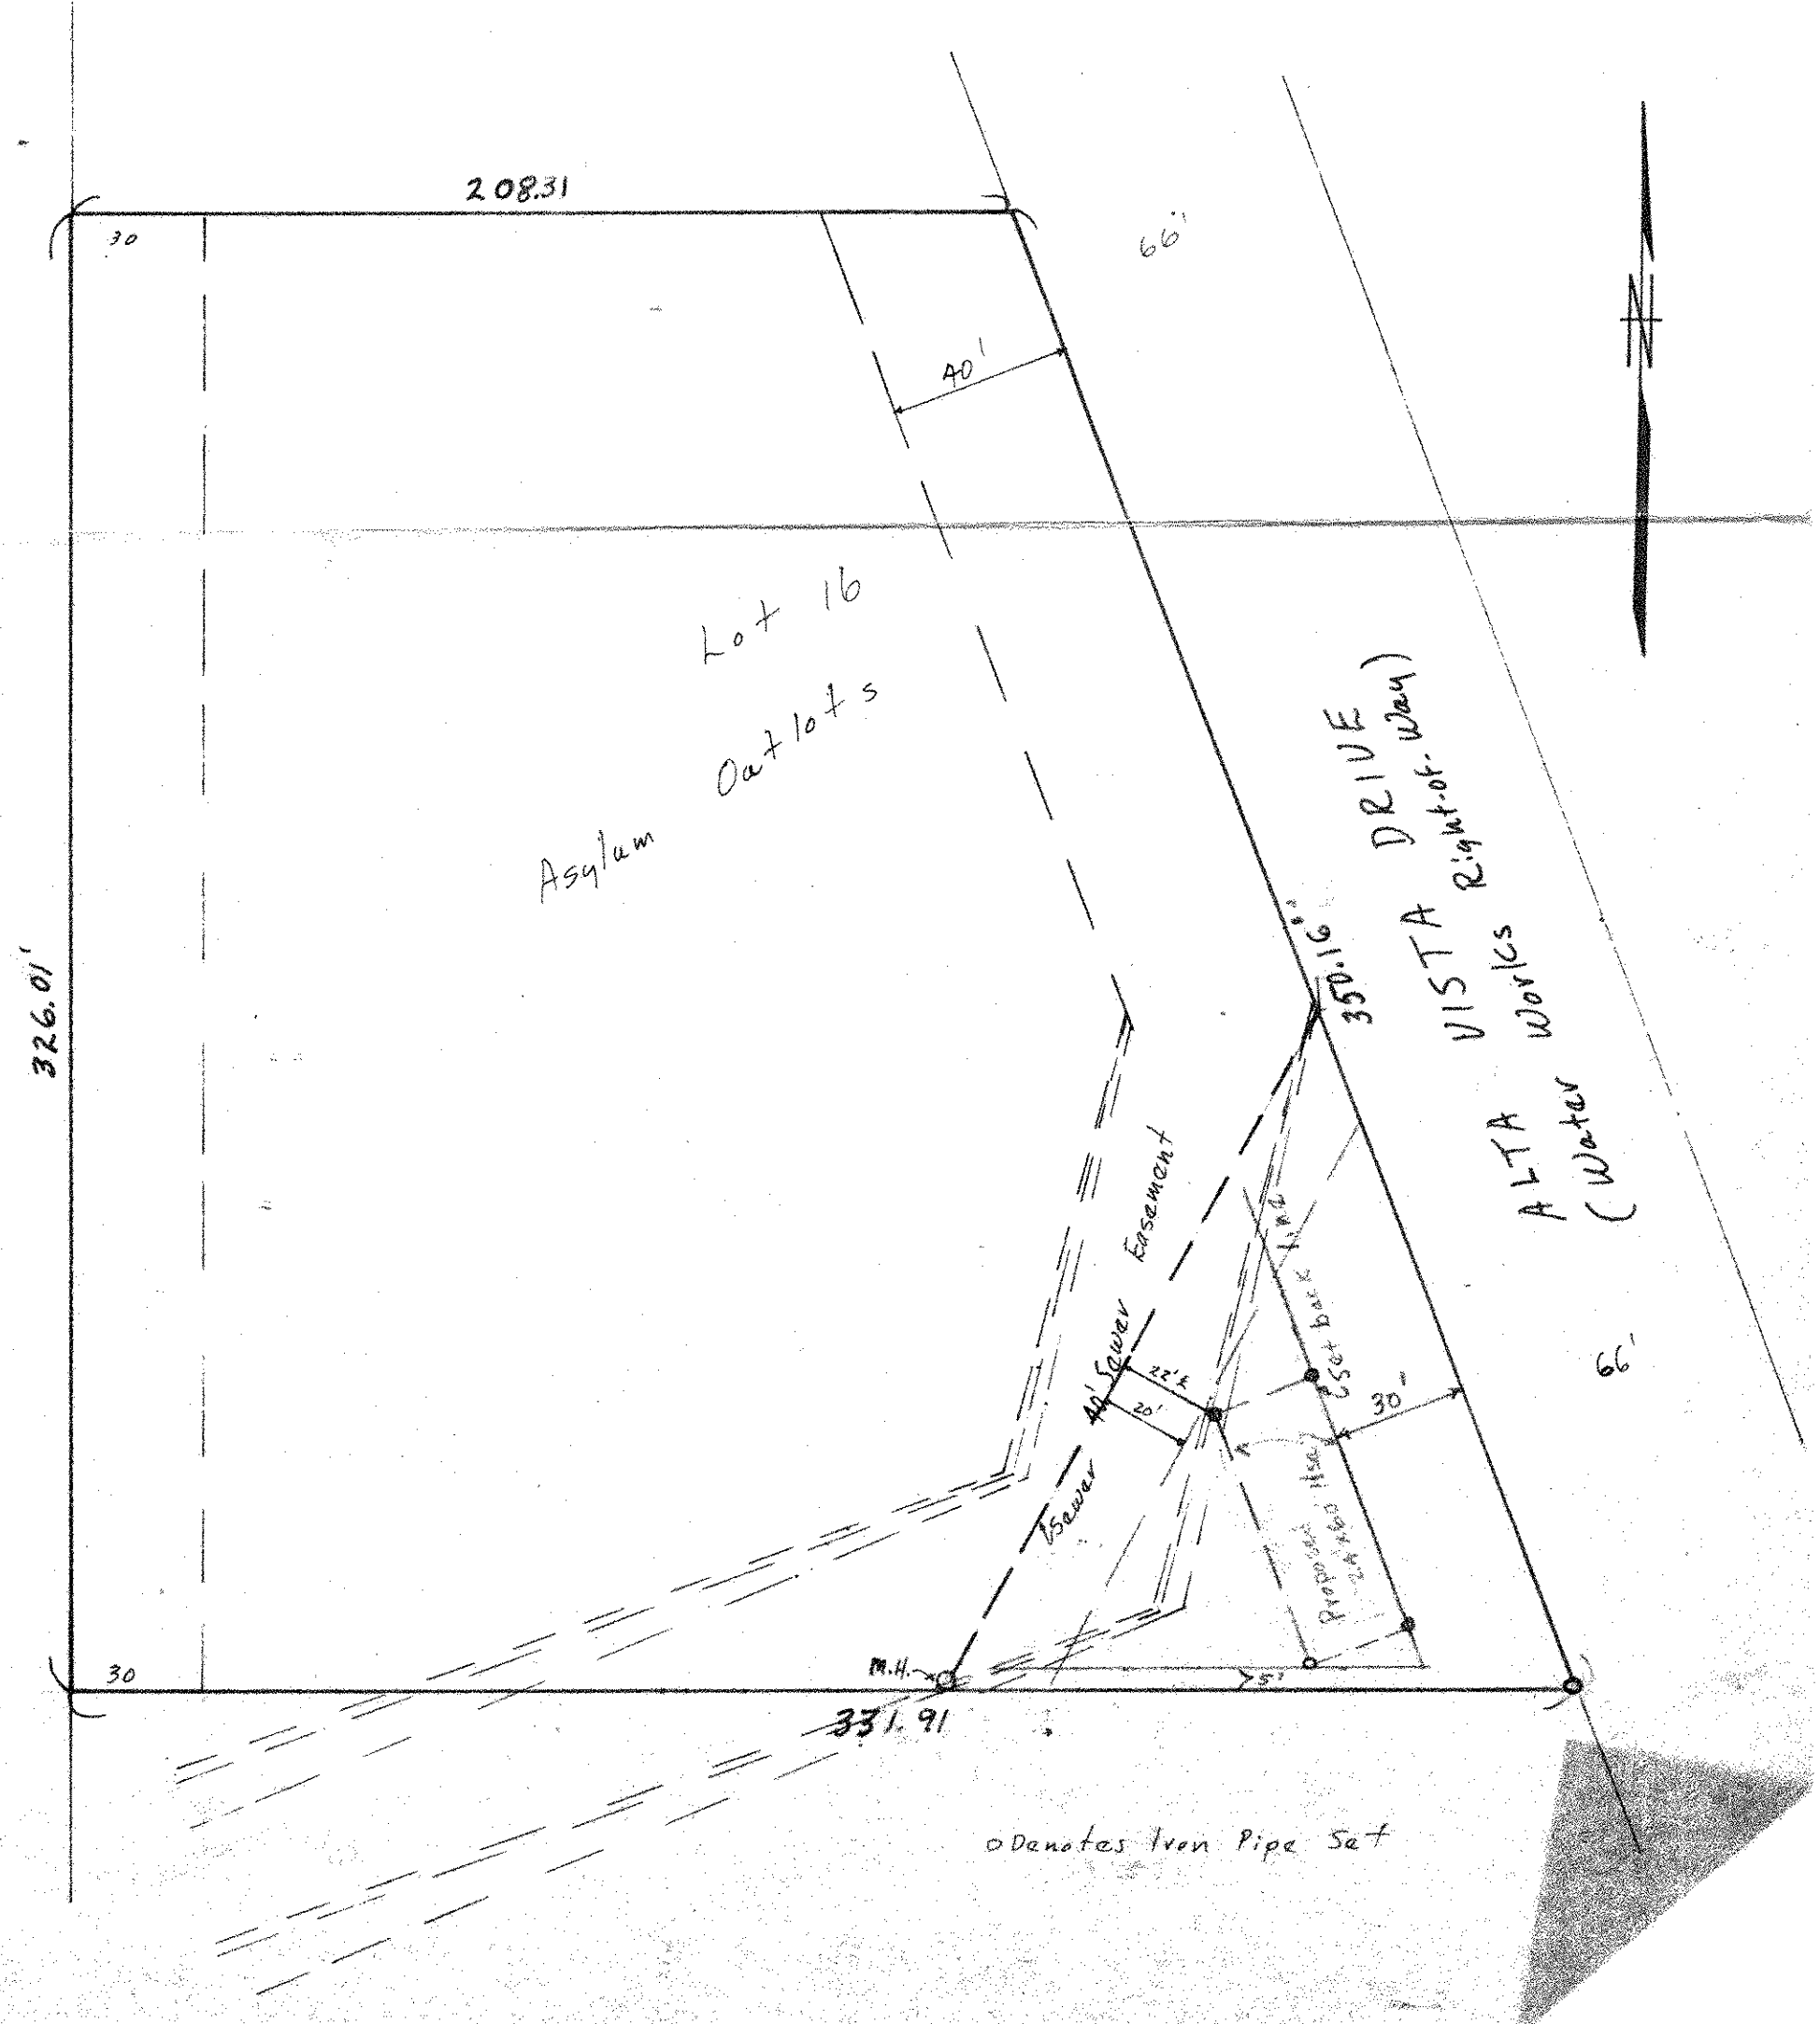
Ramsey County, Minnesota