NW 10-29-22

Certificate of Survey

From the office of

GEORGI- SCHMIDT & ASSOC. INC.

3092 No. Lexington Ave., Roseville, Mn. 55113

LAND SURVEYING

483-4408

I Hereby Certify that this plat shows a survey made by me of the property described on this plat, and that the corners are correctly placed as shown,

Job Number: 1222

Surveyed For HOLY REDEEMER CHURCH

Date AUGUST 03, 1982

Scale 1" = 100'

By Donald W. Schmidt

REGISTERED LAND SURVEYOR

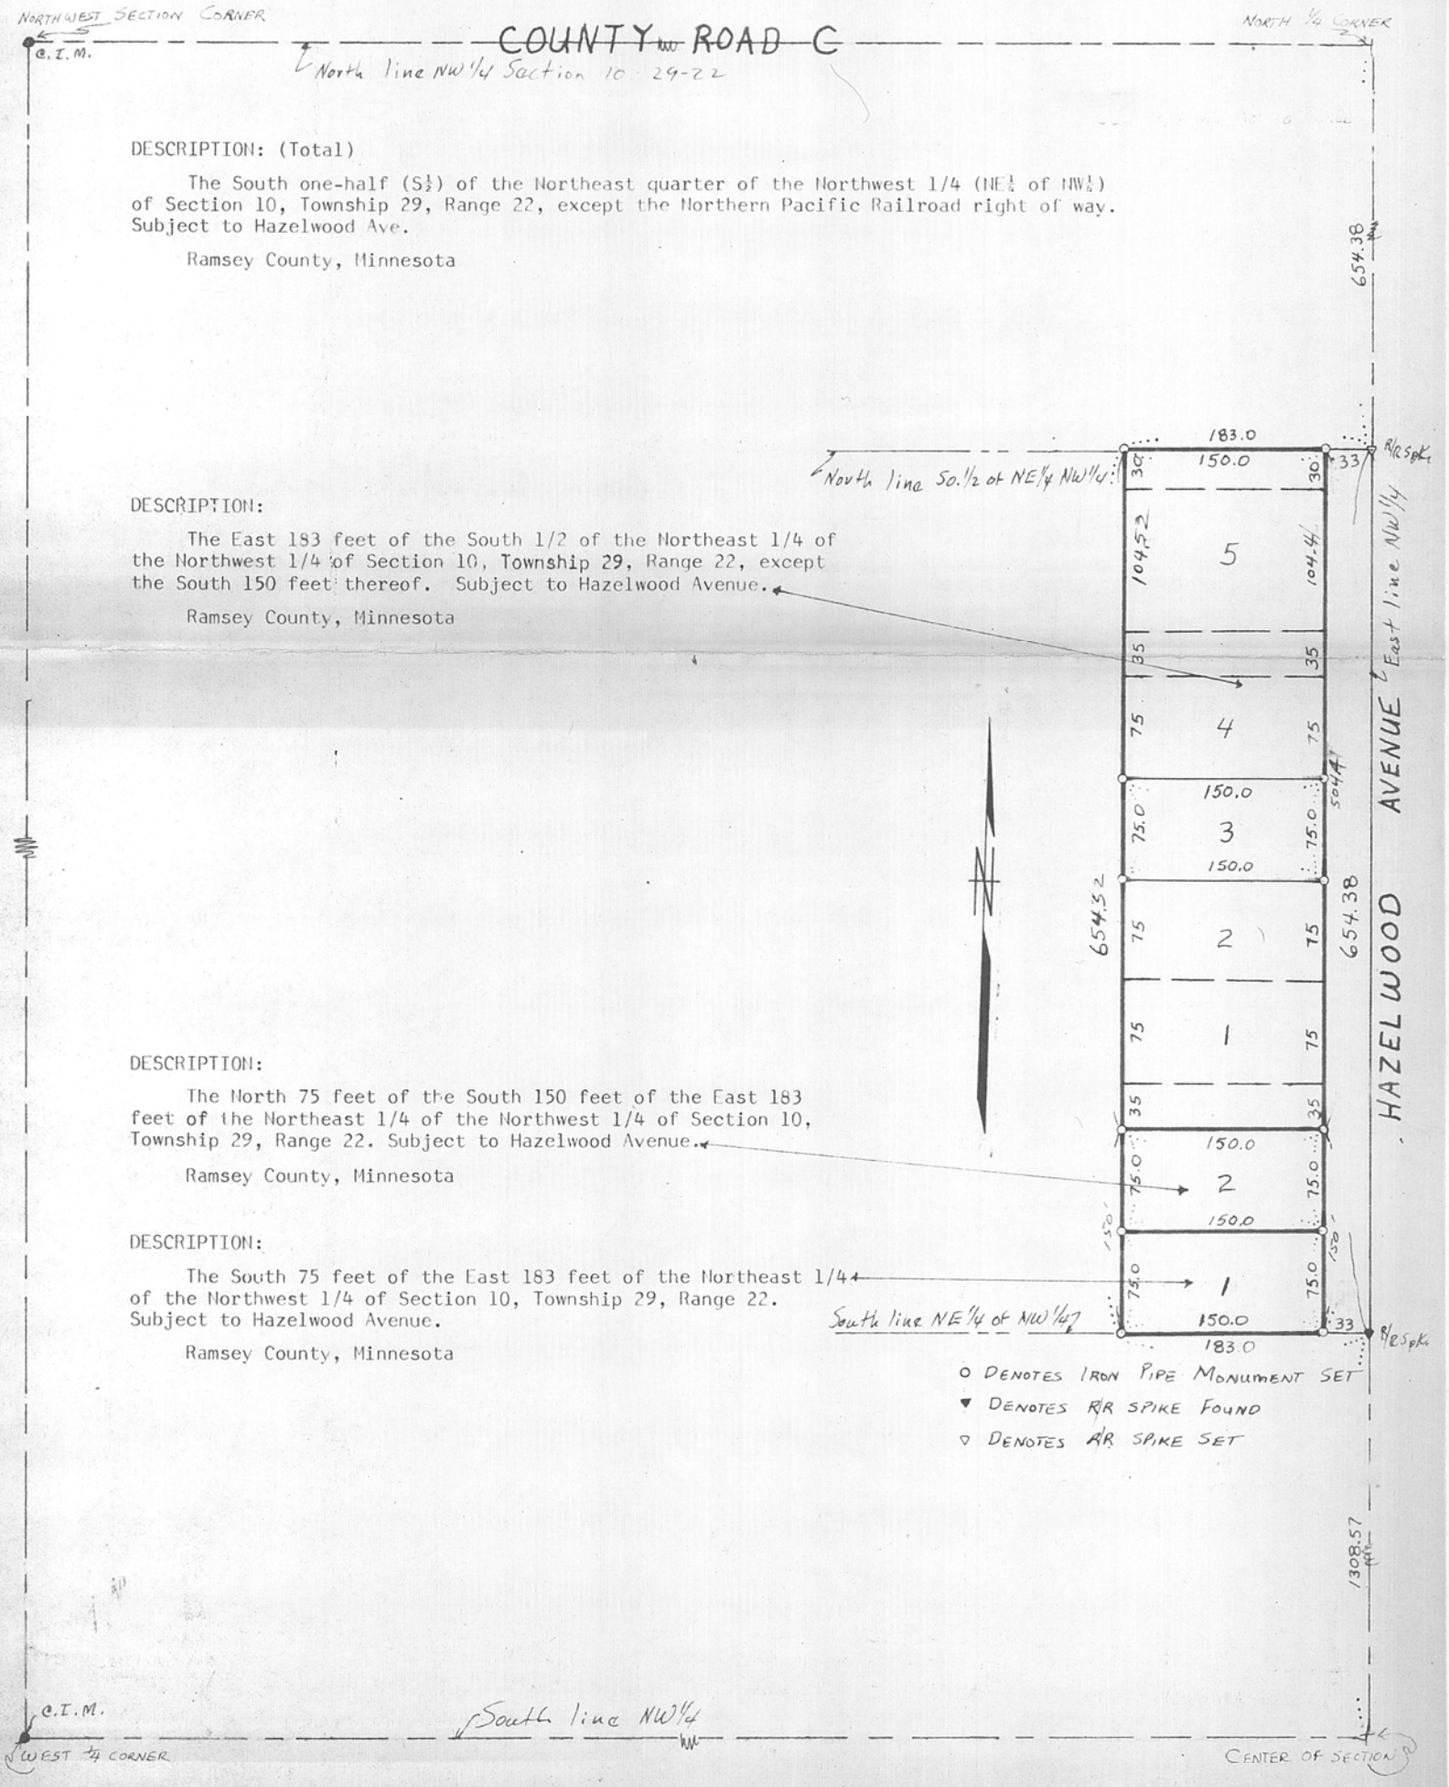

DESCRIPTION: (Total)

The South one-half (S½) of the Northeast quarter of the Northwest 1/4 (NE¼ of NW¼) of Section 10, Township 29, Range 22, except the Northern Pacific Railroad right of way. Subject to Hazelwood Ave.

Ramsey County, Minnesota

DESCRIPTION:

The East 183 feet of the South 1/2 of the Northeast 1/4 of the Northwest 1/4 of Section 10, Township 29, Range 22, except the South 150 feet thereof. Subject to Hazelwood Avenue.

Ramsey County, Minnesota

DESCRIPTION:

The North 75 feet of the South 150 feet of the East 183 feet of the Northeast 1/4 of the Northwest 1/4 of Section 10, Township 29, Range 22. Subject to Hazelwood Avenue.

Ramsey County, Minnesota

DESCRIPTION:

The South 75 feet of the East 183 feet of the Northeast 1/4 of the Northwest 1/4 of Section 10, Township 29, Range 22. Subject to Hazelwood Avenue.

Ramsey County, Minnesota

○ DENOTES IRON PIPE MONUMENT SET

▼ DENOTES R/R SPIKE FOUND

▽ DENOTES R/R SPIKE SET