NW 12 30 22

Certificate of Survey

From the office of

GEORGI- SCHMIDT & ASSOC. INC.

3092 No. Lexington Ave., Roseville, Mn. 55113

LAND SURVEYING

483-4408

I Hereby Certify that this plat shows a survey made by me of the property described on this plat, and that the corners are correctly placed as shown, and that all locations have been correctly shown

Job Number: 938

Surveyed For John Steinworth

Date 5/13/81 - 4/29/82 Added House location

Scale 1" = 30'

By Donald W. Schmidt
REGISTERED LAND SURVEYOR

DESCRIPTION:

That part of the West 330 feet of the East 1/2 of the NE 1/4 of the NW 1/4 of Section 12, T30N, R22W lying North of the centerline of Taylor Avenue and East of Shady Side Addition # 2. Subject to Taylor Avenue and Cantwell Street.

Ramsey County, Minnesota

"The undersigned, a duly licensed surveyor in the State of Minnesota, hereby certifies to John Steinworth and Evans Financial Corporation, that the survey map herein was made pursuant to the minimum standards adopted by the Association of Professional Land Surveyors".

Donald W. Schmidt
Minnesota Registration No. 10459

Dated: 5/4 1982.

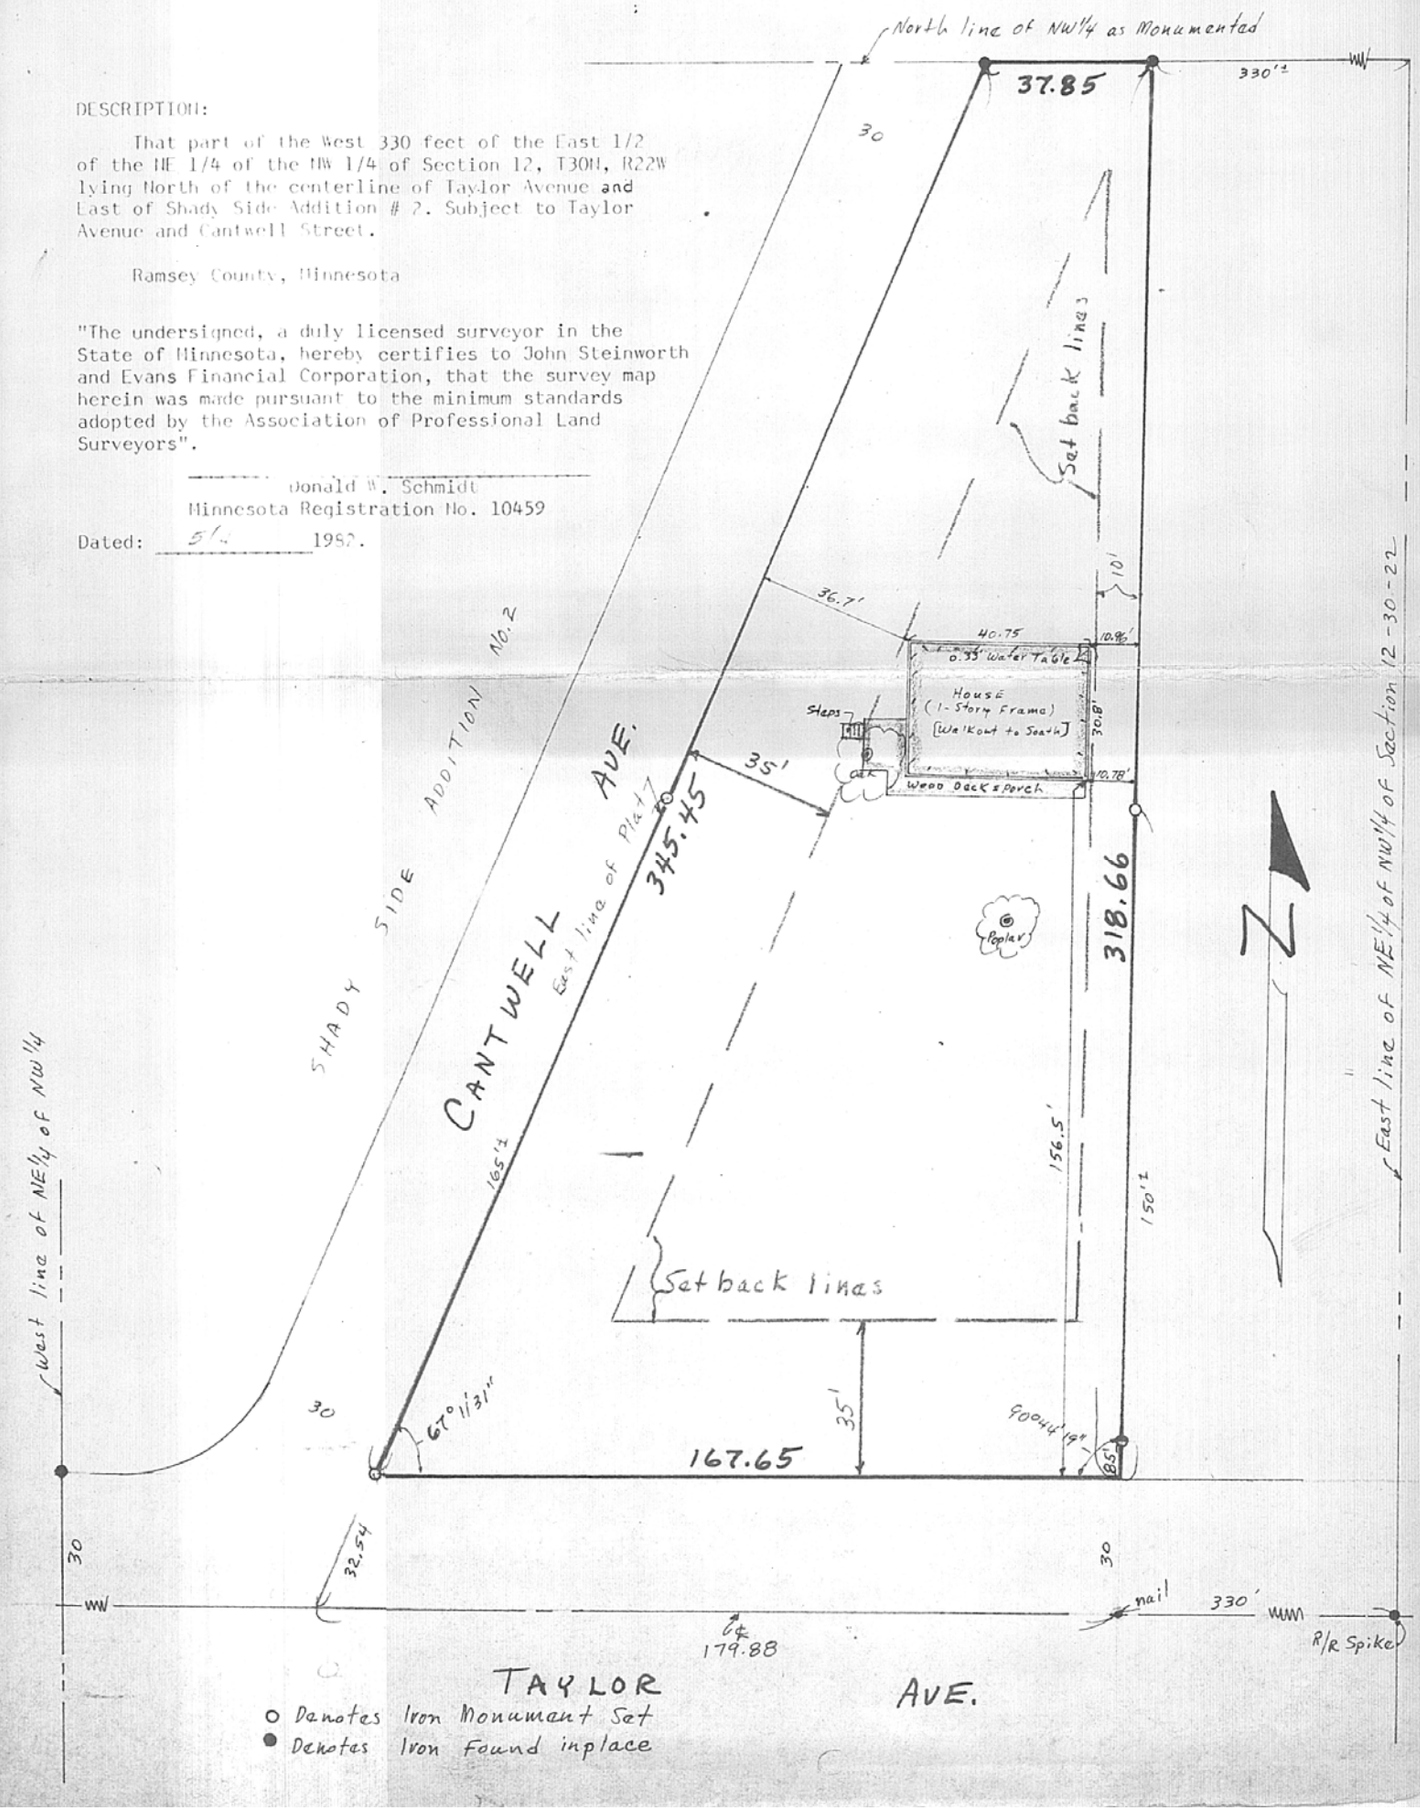

○ Denotes Iron Monument Set

● Denotes Iron Found inplace