

Certificate of Survey

From the office of
GEORGI-SCHMIDT & ASSOC. INC.
3092 No. Lexington Ave., Roseville, Mn. 55113
LAND SURVEYING
483-4408

I Hereby Certify that this plat shows a survey made by me of the property described on this plat, and that the corners are correctly placed as shown,

Job Number: 1120

Surveyed For GORDON HEDLUND

Date SEPTEMBER, 1982


Scale 1" = 40'

By Donald W. Schmidt
REGISTERED LAND SURVEYOR
#10459

Description:

lot 5, Block 2, Leier Estates

Ramsay County, MN.

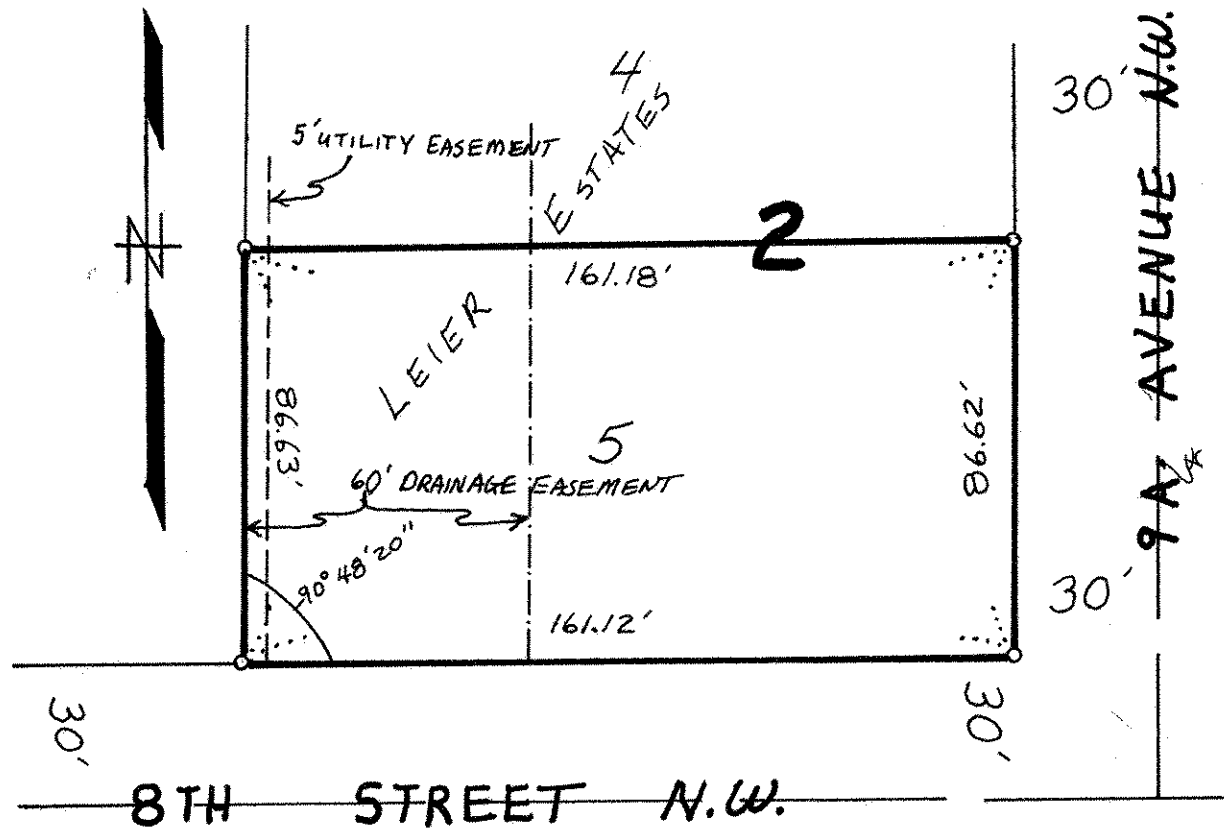

○ DENOTES IRON PIPE MONUMENT SET