SW 17 29 23

Certificate of Survey

From the office of

GEORGI- SCHMIDT & ASSOC. INC.

3092 No. Lexington Ave., Roseville, Mn. 55113

LAND SURVEYING

483-4408

I Hereby Certify that this plat shows a survey made by me of the property described on this plat, and that the corners are correctly placed as shown.

Job Number: 1226

Surveyed For Lempi Haataja

Date 8/11/82

Scale 1"=40'

By Donald W. Schmidt

REGISTERED LAND SURVEYOR

10459

Description:

Lot 19, Block 1, Rosa Hill Addition

Ramsay County, MN.

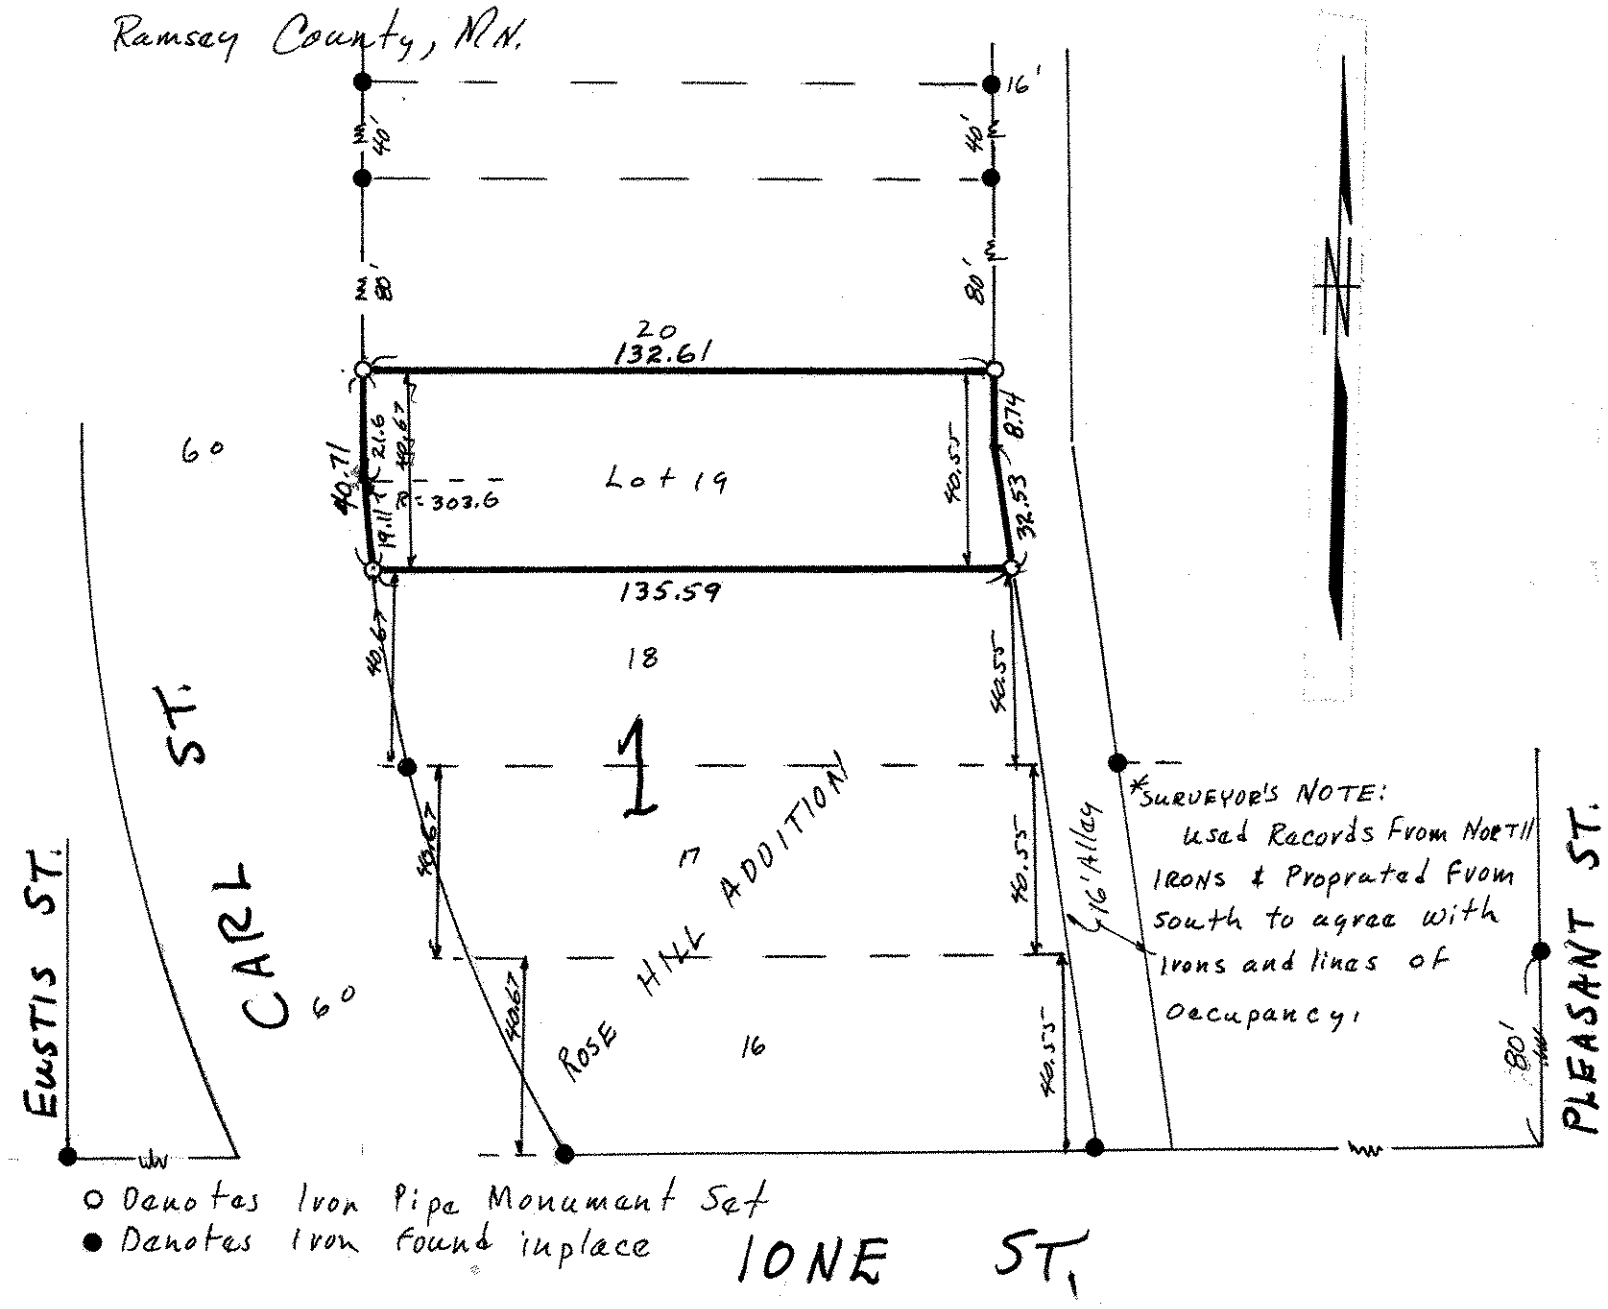

○ Denotes Iron Pipe Monument Set

● Denotes Iron Found inplace