SE 33 29 23

Certificate of Survey

From the office of

GEORGI- SCHMIDT & ASSOC. INC.

3092 No. Lexington Ave., Roseville, Mn. 55113
LAND SURVEYING
483-4408

I Hereby Certify that this plat shows a survey made by me of the property described on this plat, and that the corners are correctly placed as shown.

Job Number: 1171

Surveyed For Bob Heille

Date 6/14/82

Scale 1" = 30'

By Donald W. Schmidt
REGISTERED LAND SURVEYOR
Under Laws of State of Mn. #10459

Description:

The West 4.0 feet of Lot 3 and all of Lot 4, Conver and Theopolds Rearrangement of Block 8, Excelsior Park. Ramsey County, Minnesota

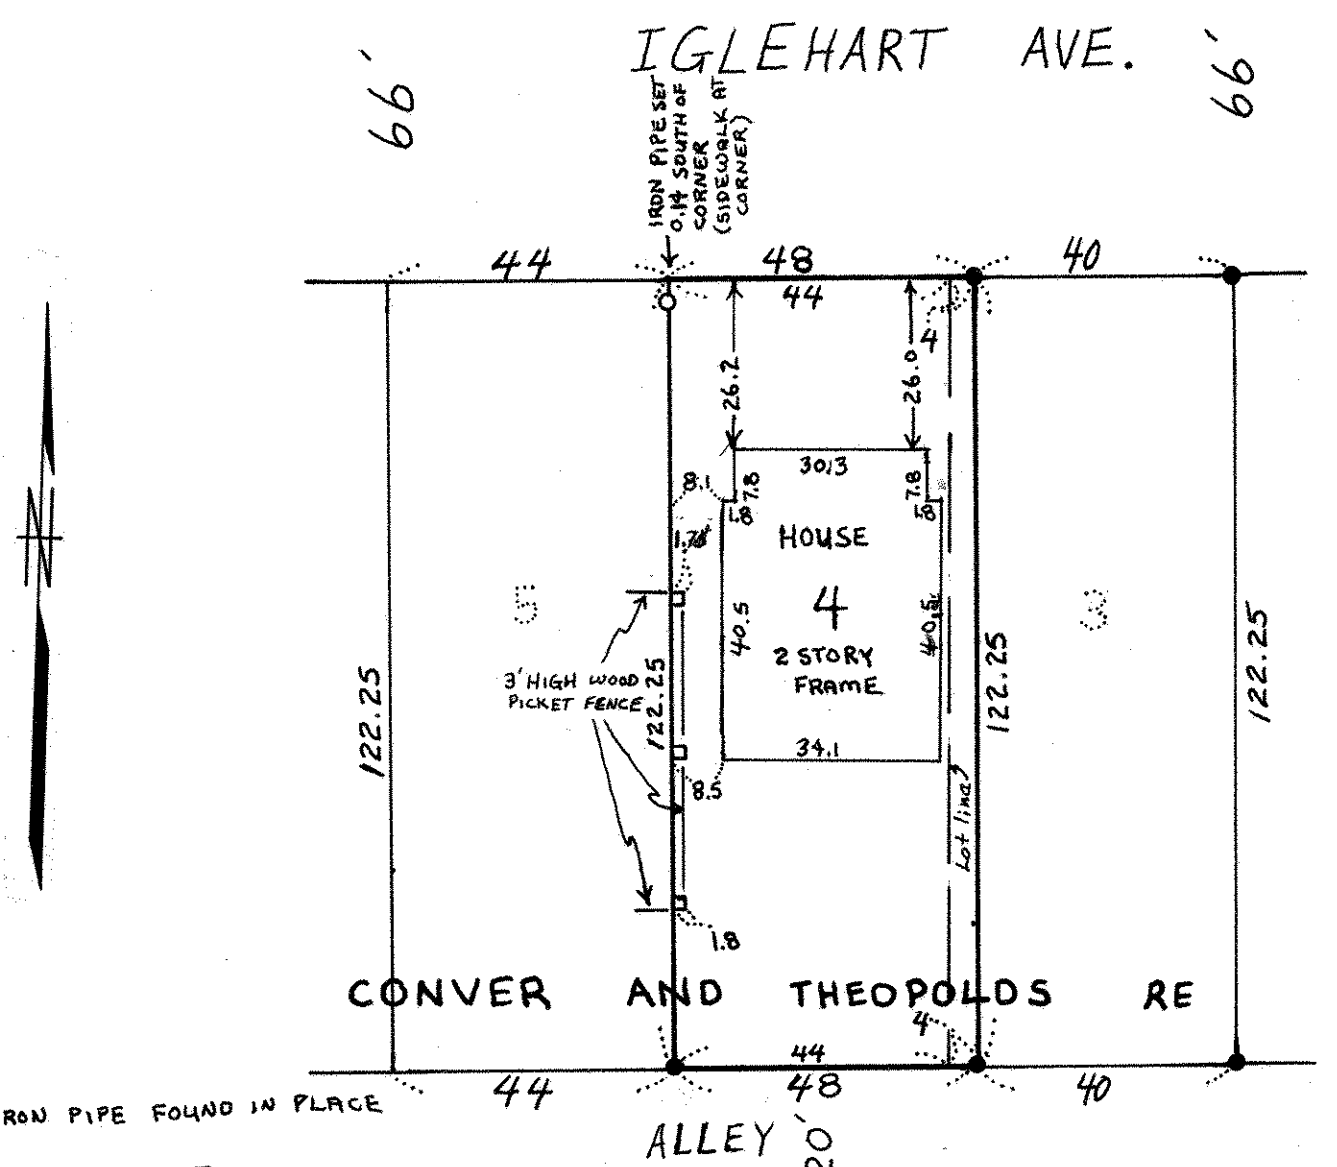

● DENOTES IRON PIPE FOUND IN PLACE

O DENOTES IRON PIPE SET