SW 2-29-23

Certificate of Survey

From the office of

GEORGI- SCHMIDT & ASSOC. INC.

3092 No. Lexington Ave., Roseville, Mn. 55113

LAND SURVEYING

483-4408

I Hereby Certify that this plat shows a survey made by me of the property described on this plat, and that the corners are correctly placed as shown.

Job Number: 1247

Surveyed For George Reiling

Date 9/9/82

Scale 1" = 40'

By Donald W. Schmidt

REGISTERED LAND SURVEYOR

#10459

Description:

Lot 4, except that part thereof taken for opening Aglen Avenue, and the East 20 feet of Lot 3, all in Block 1, Gilbert Reiling's Addition.
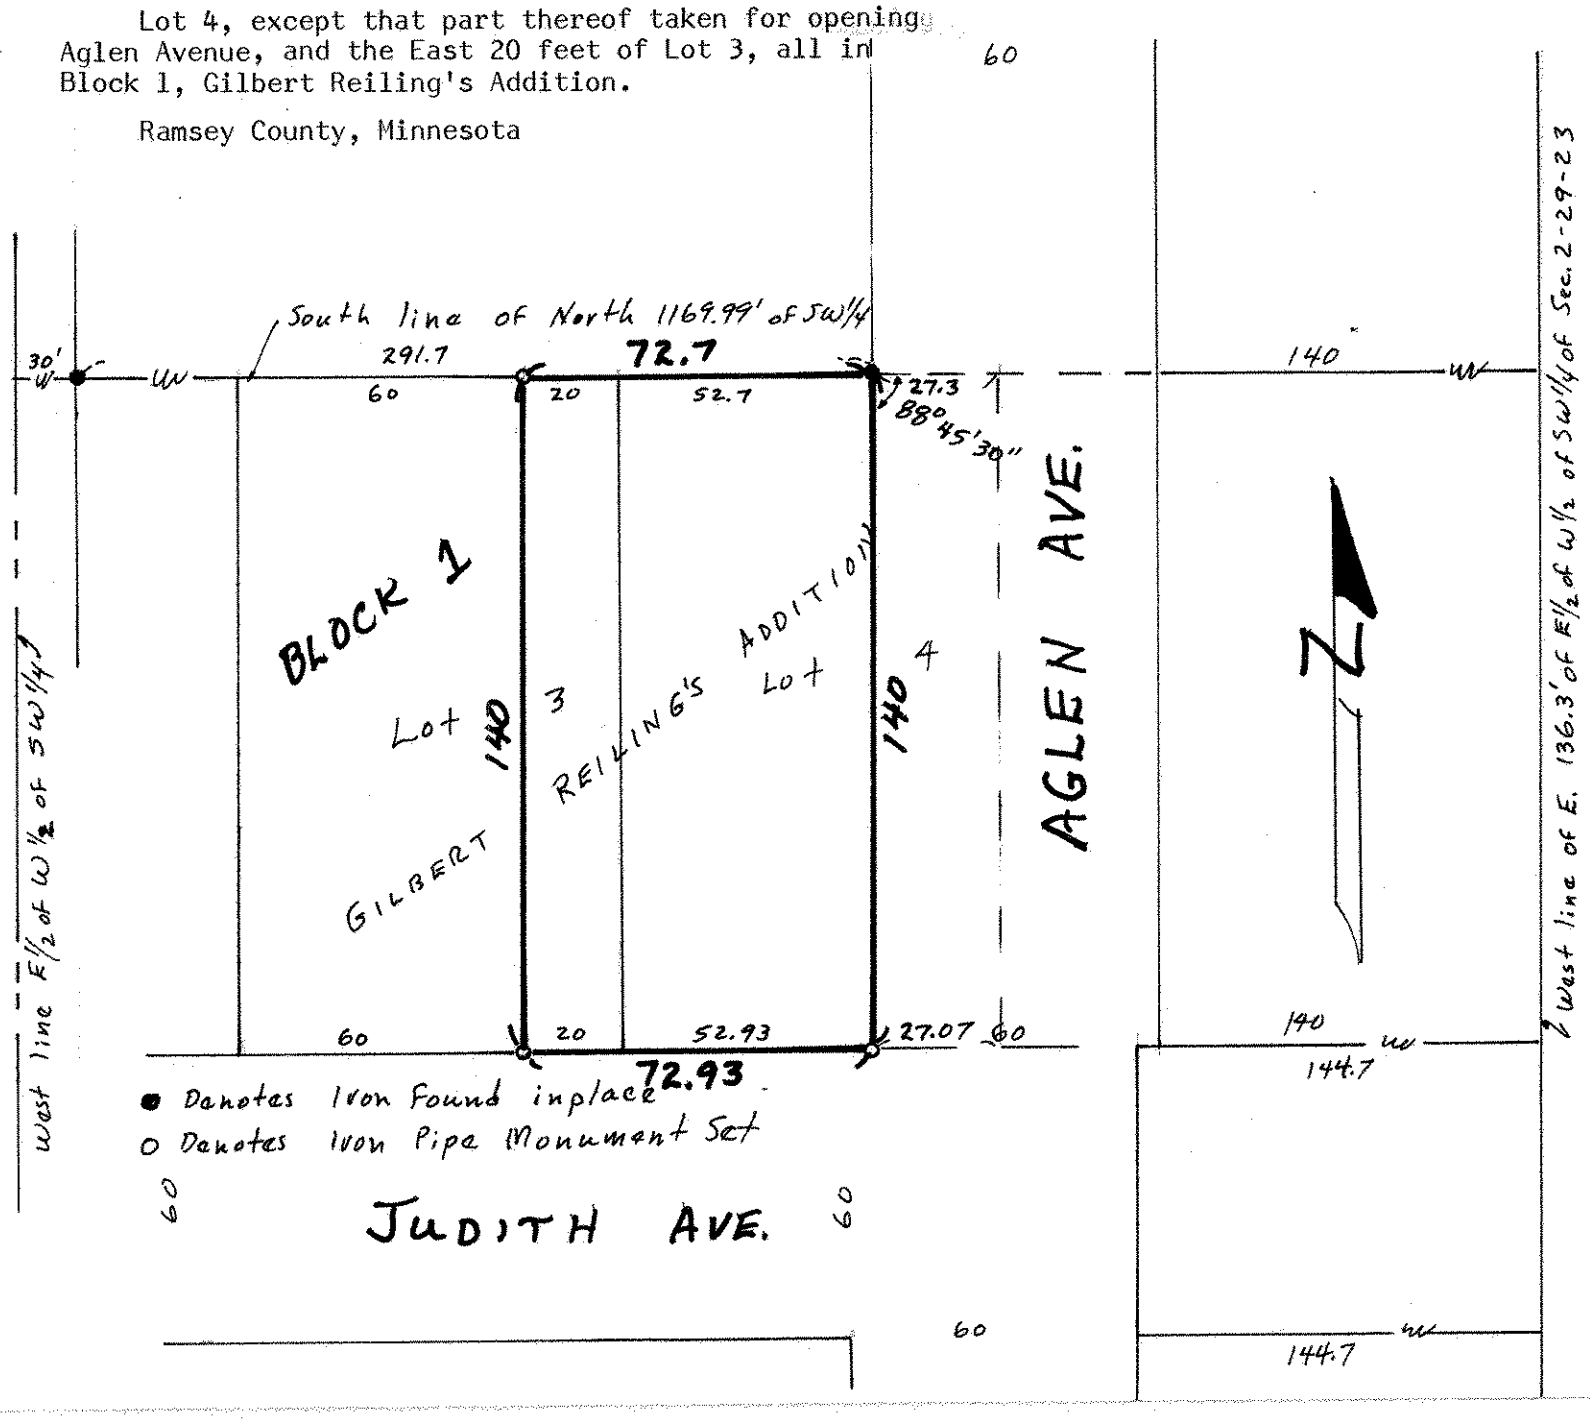
Ramsey County, Minnesota