

NE - 7 - 29 - 22

Certificate of Survey

From the office of
GEORGI-SCHMIDT & ASSOC. INC.
3092 No. Lexington Ave., Roseville, Mn. 55113
LAND SURVEYING
483-4408

I Hereby Certify that this plat shows a survey made by me of the property described on this plat, and that the corners are correctly placed as shown,

Job Number: 1250

Surveyed For Tom LINZMEYER


Date SEPTEMBER 14, 1982

Scale 1" = 50'

By Donald W. Schmidt
REGISTERED LAND SURVEYOR
#10459

Description:

Lot 1, Block 2, Roy Wilson Addition
Ramsey County, Minnesota

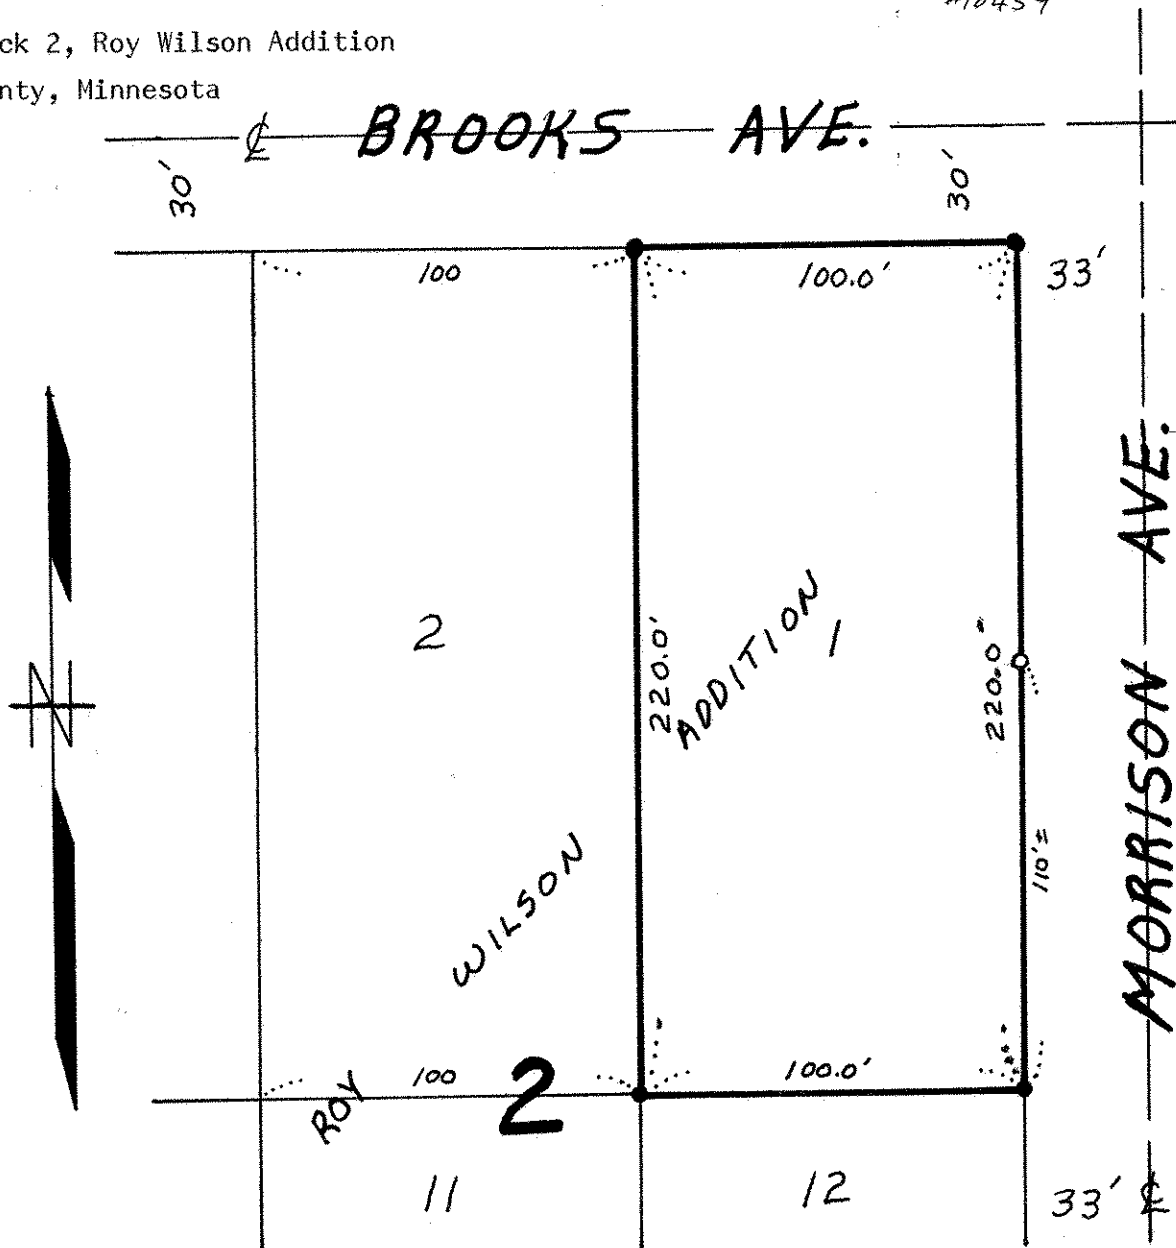

● DENOTES IRON PIPE MONUMENT FOUND
○ DENOTES IRON PIPE SET