Certificate of Survey

From the office of

GEORGI- SCHMIDT & ASSOC. INC.

3092 No. Lexington Ave., Roseville, Mn. 55113 LAND SURVEYING 483-4408

I Hereby Certify that this plat shows a survey made by me of the property described on this plat, and that the corners are correctly placed as shown, and that all locations have been correctly shown.


Job Number: 1147 Surveyed For 6/ann Beecham

Date 5/6/82

Scale 1"= 40' By kmald W.

Description:

Lots 1, 2 and 3, Block 1, Donnelly's Addition to St. Paul. Ramsey County, Minnesota

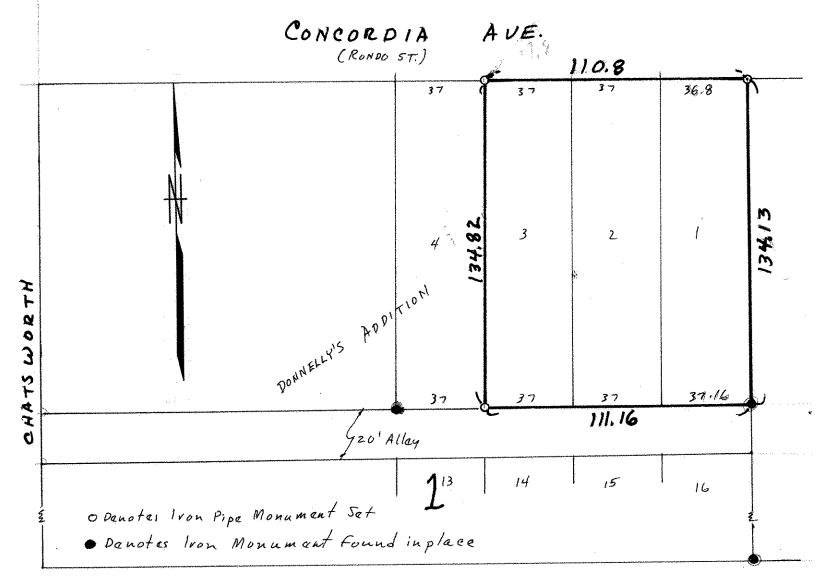

CARROLL AVE.