


OPEN SPACE PROJ. NO. 71-3

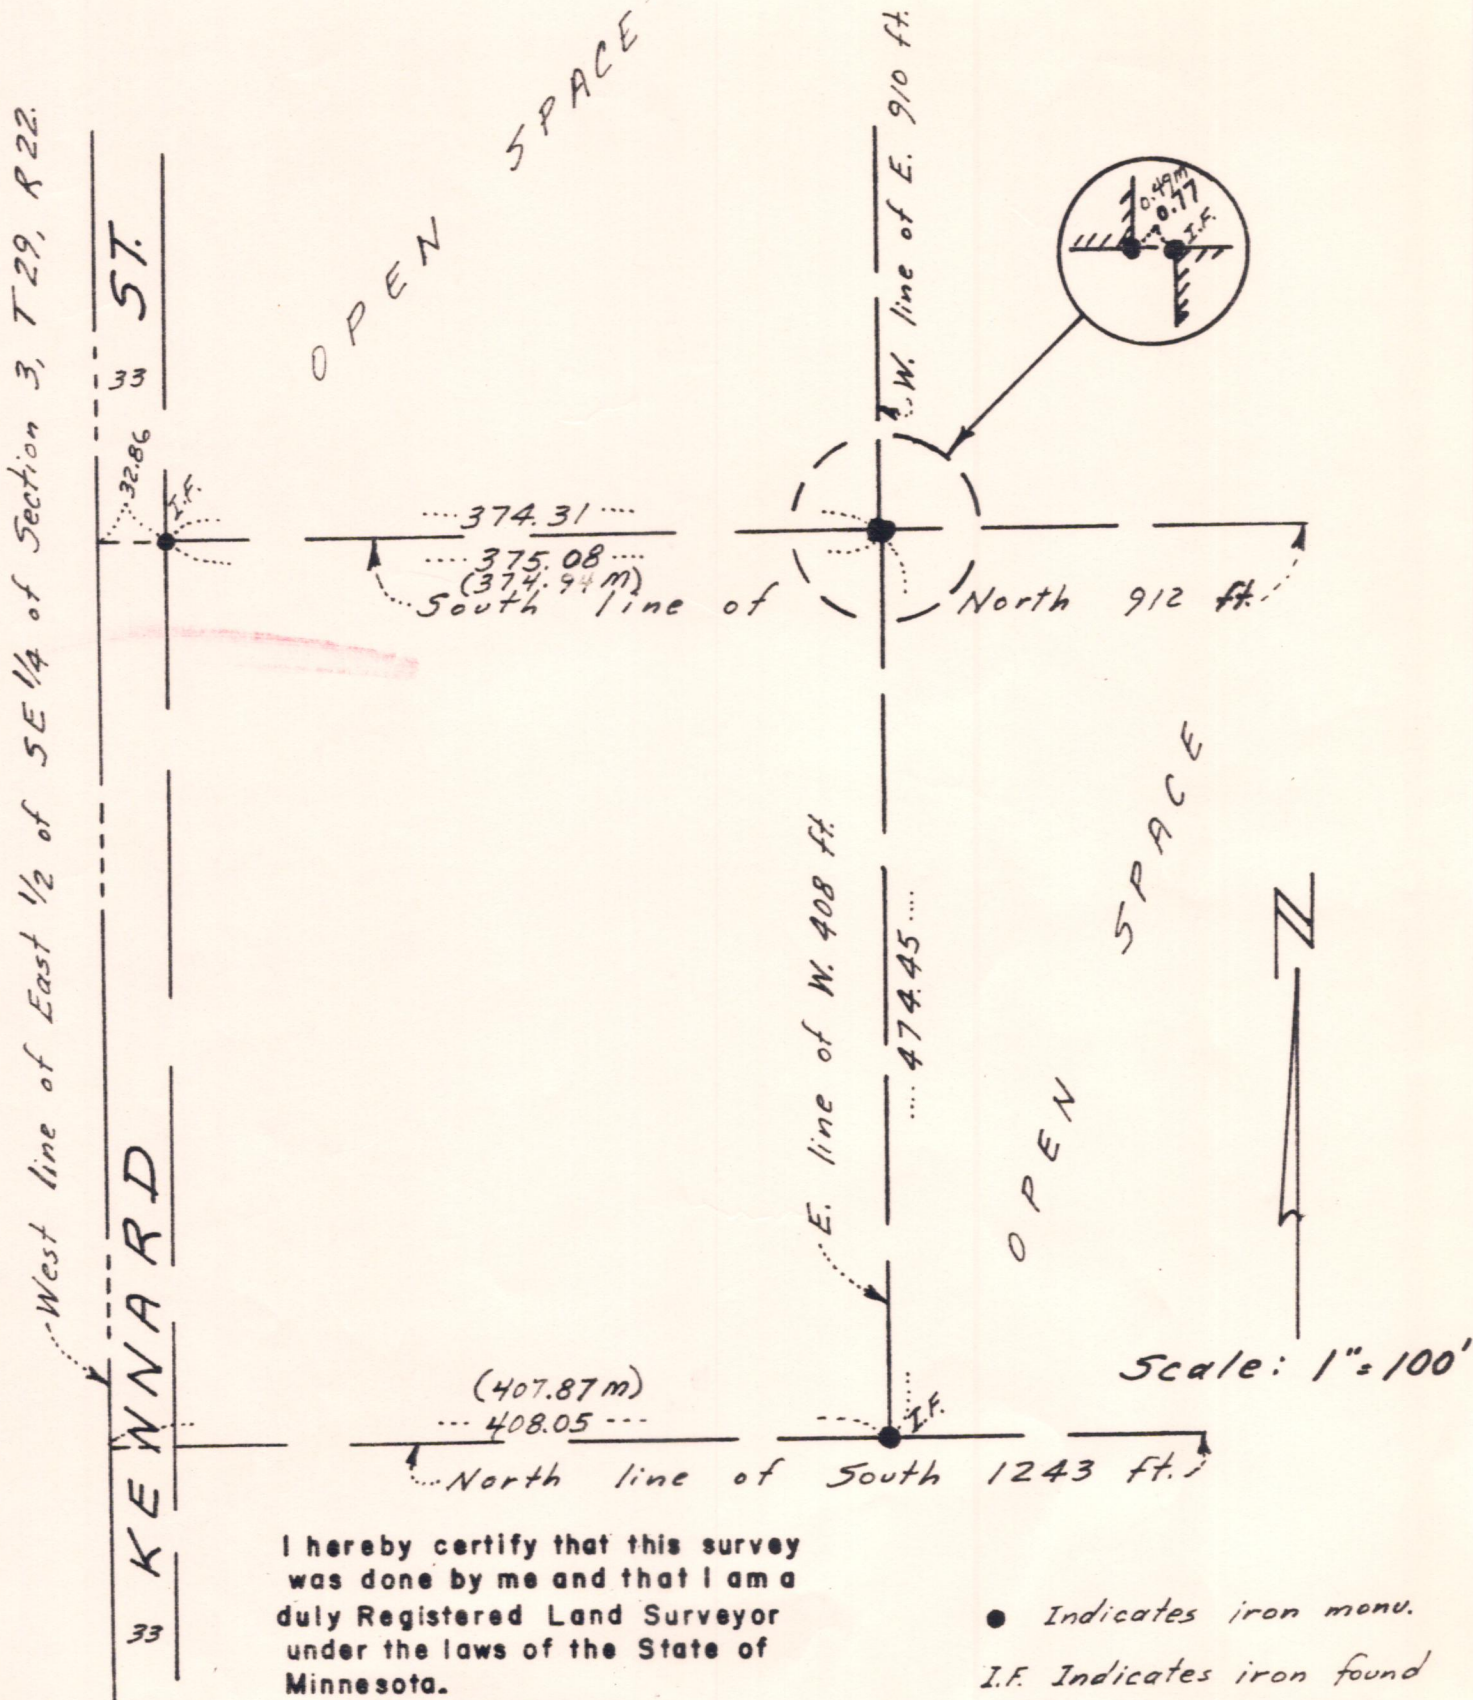

I hereby certify that this survey was done by me and that I am a duly Registered Land Surveyor under the laws of the State of Minnesota.

Ronald F. Meyer
 Reg. No. 9051

Date: 1-10-83

- Indicates iron monu.
- I.F. Indicates iron found
- M Indicates measured