NW 29 29 22

Certificate of Survey

From the office of

GEORGI- SCHMIDT & ASSOC. INC.

3092 No. Lexington Ave., Roseville, Mn. 55113
LAND SURVEYING
483-4408

I Hereby Certify that this plat shows a survey made by me of the property described on this plat, and that the corners are correctly placed as shown.

Job Number: 1410

Surveyed For Dave Parkins
Date 6/17/83
Scale 1" = 50'

By Donald W Schmidt
REGISTERED LAND SURVEYOR
#10459

Description: (As furnished)

The East 40 feet of the West 80 feet of Lots 12, 13 and 14, Block 16, Fairview Addition.
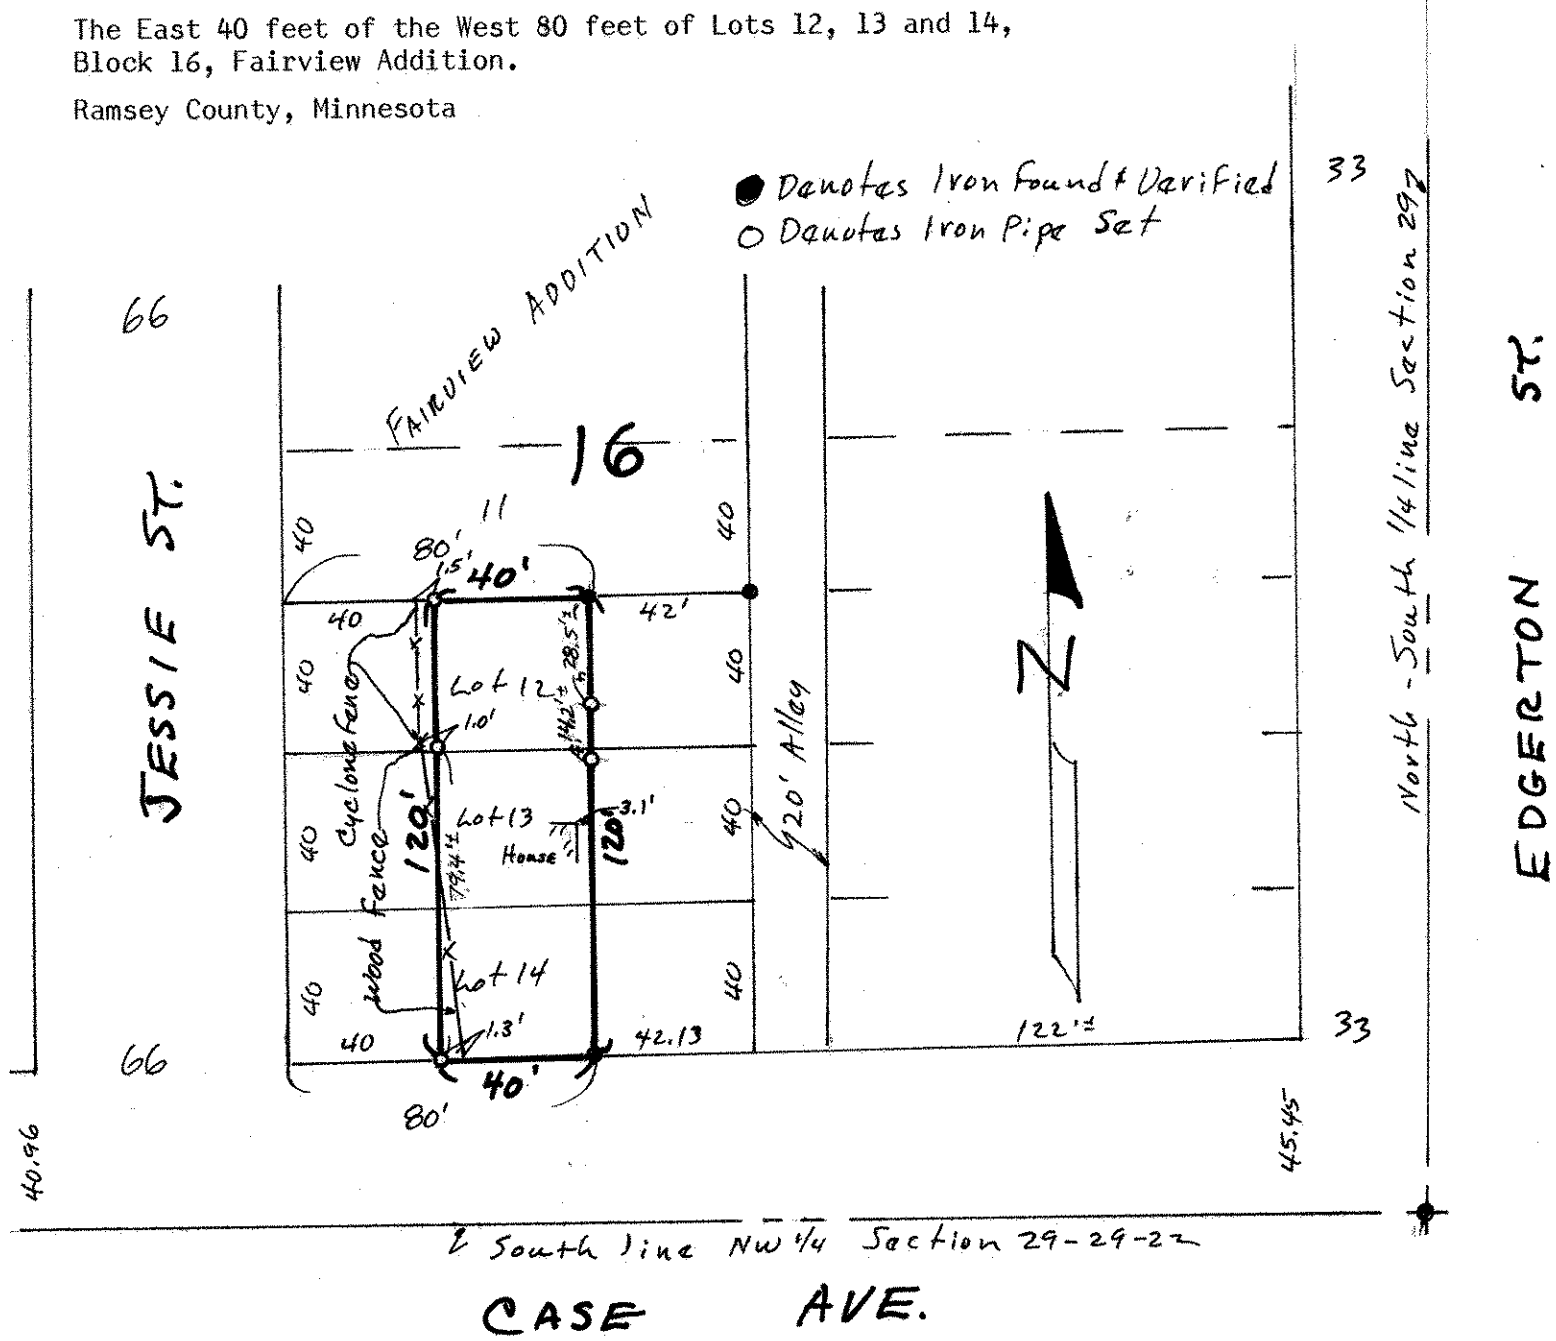
Ramsey County, Minnesota