## Gertificate of Survey

Job Number: 1348

From the office of

## GEORGI- SCHMIDT & ASSOC. INC.

3092 No. Lexington Ave., Roseville, Mn. 55113 LAND SURVEYING 483-4408

I Hereby Certify that this plat shows a survey made by me of the property described on this plat, and that the corners are correctly placed as shown.

Surveyed For Belair Builders Inc.

Date 3/30/83


Scale /"= 40'

By Schweelt

# 10459

## Description:

Lot 17, Block 1, Belair Lake Josephine Heights No. 2 Ramsey County, Minnesota

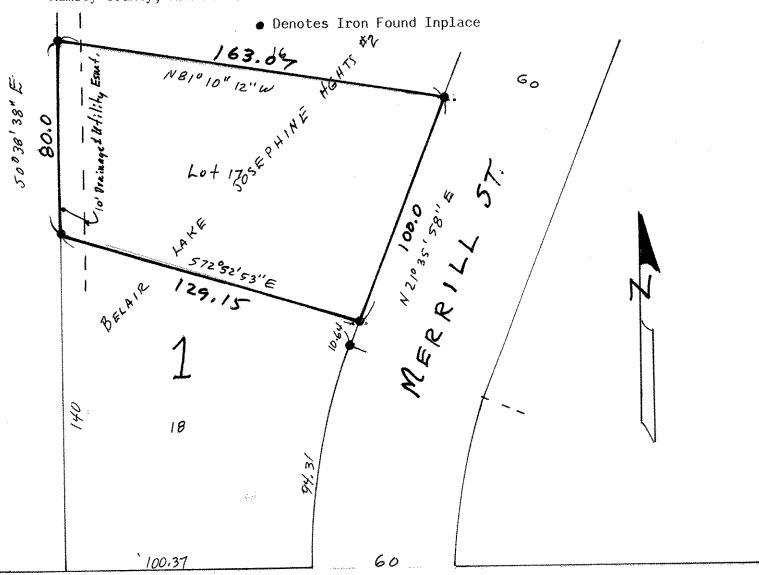

COUNTY ROAD C2