
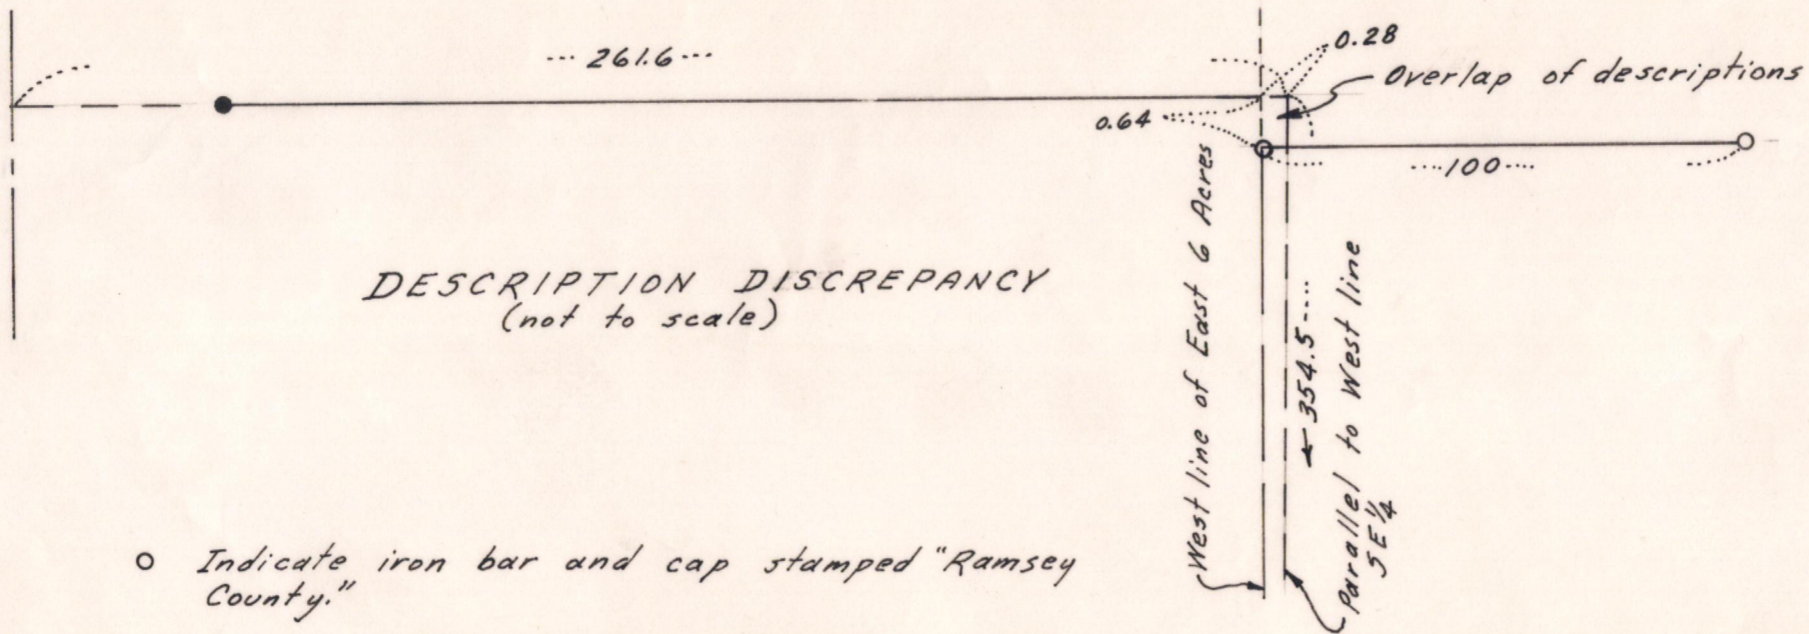
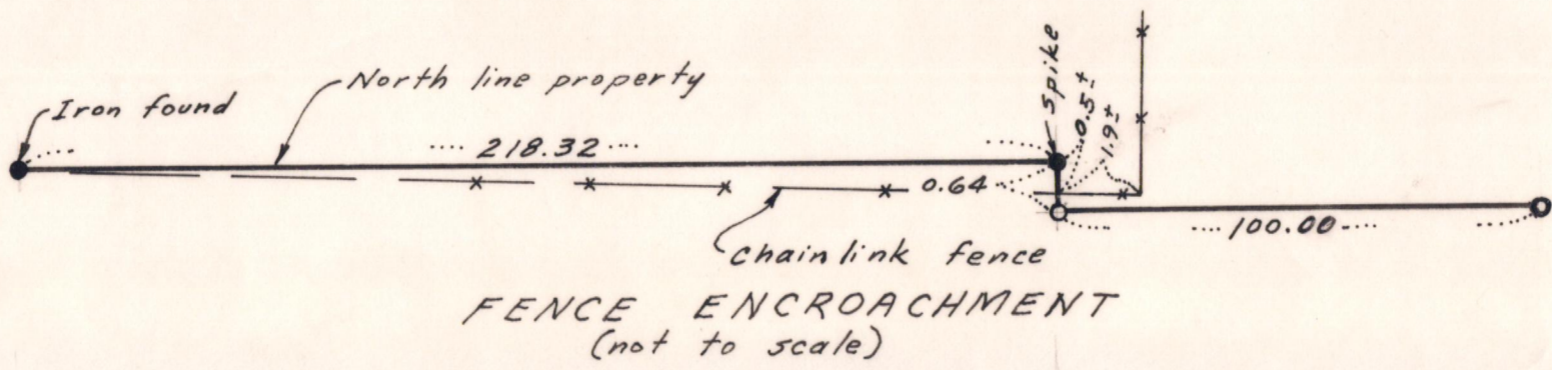


CERTIFICATE OF SURVEY

DEPARTMENT OF PUBLIC WORKS
OF RAMSEY COUNTY

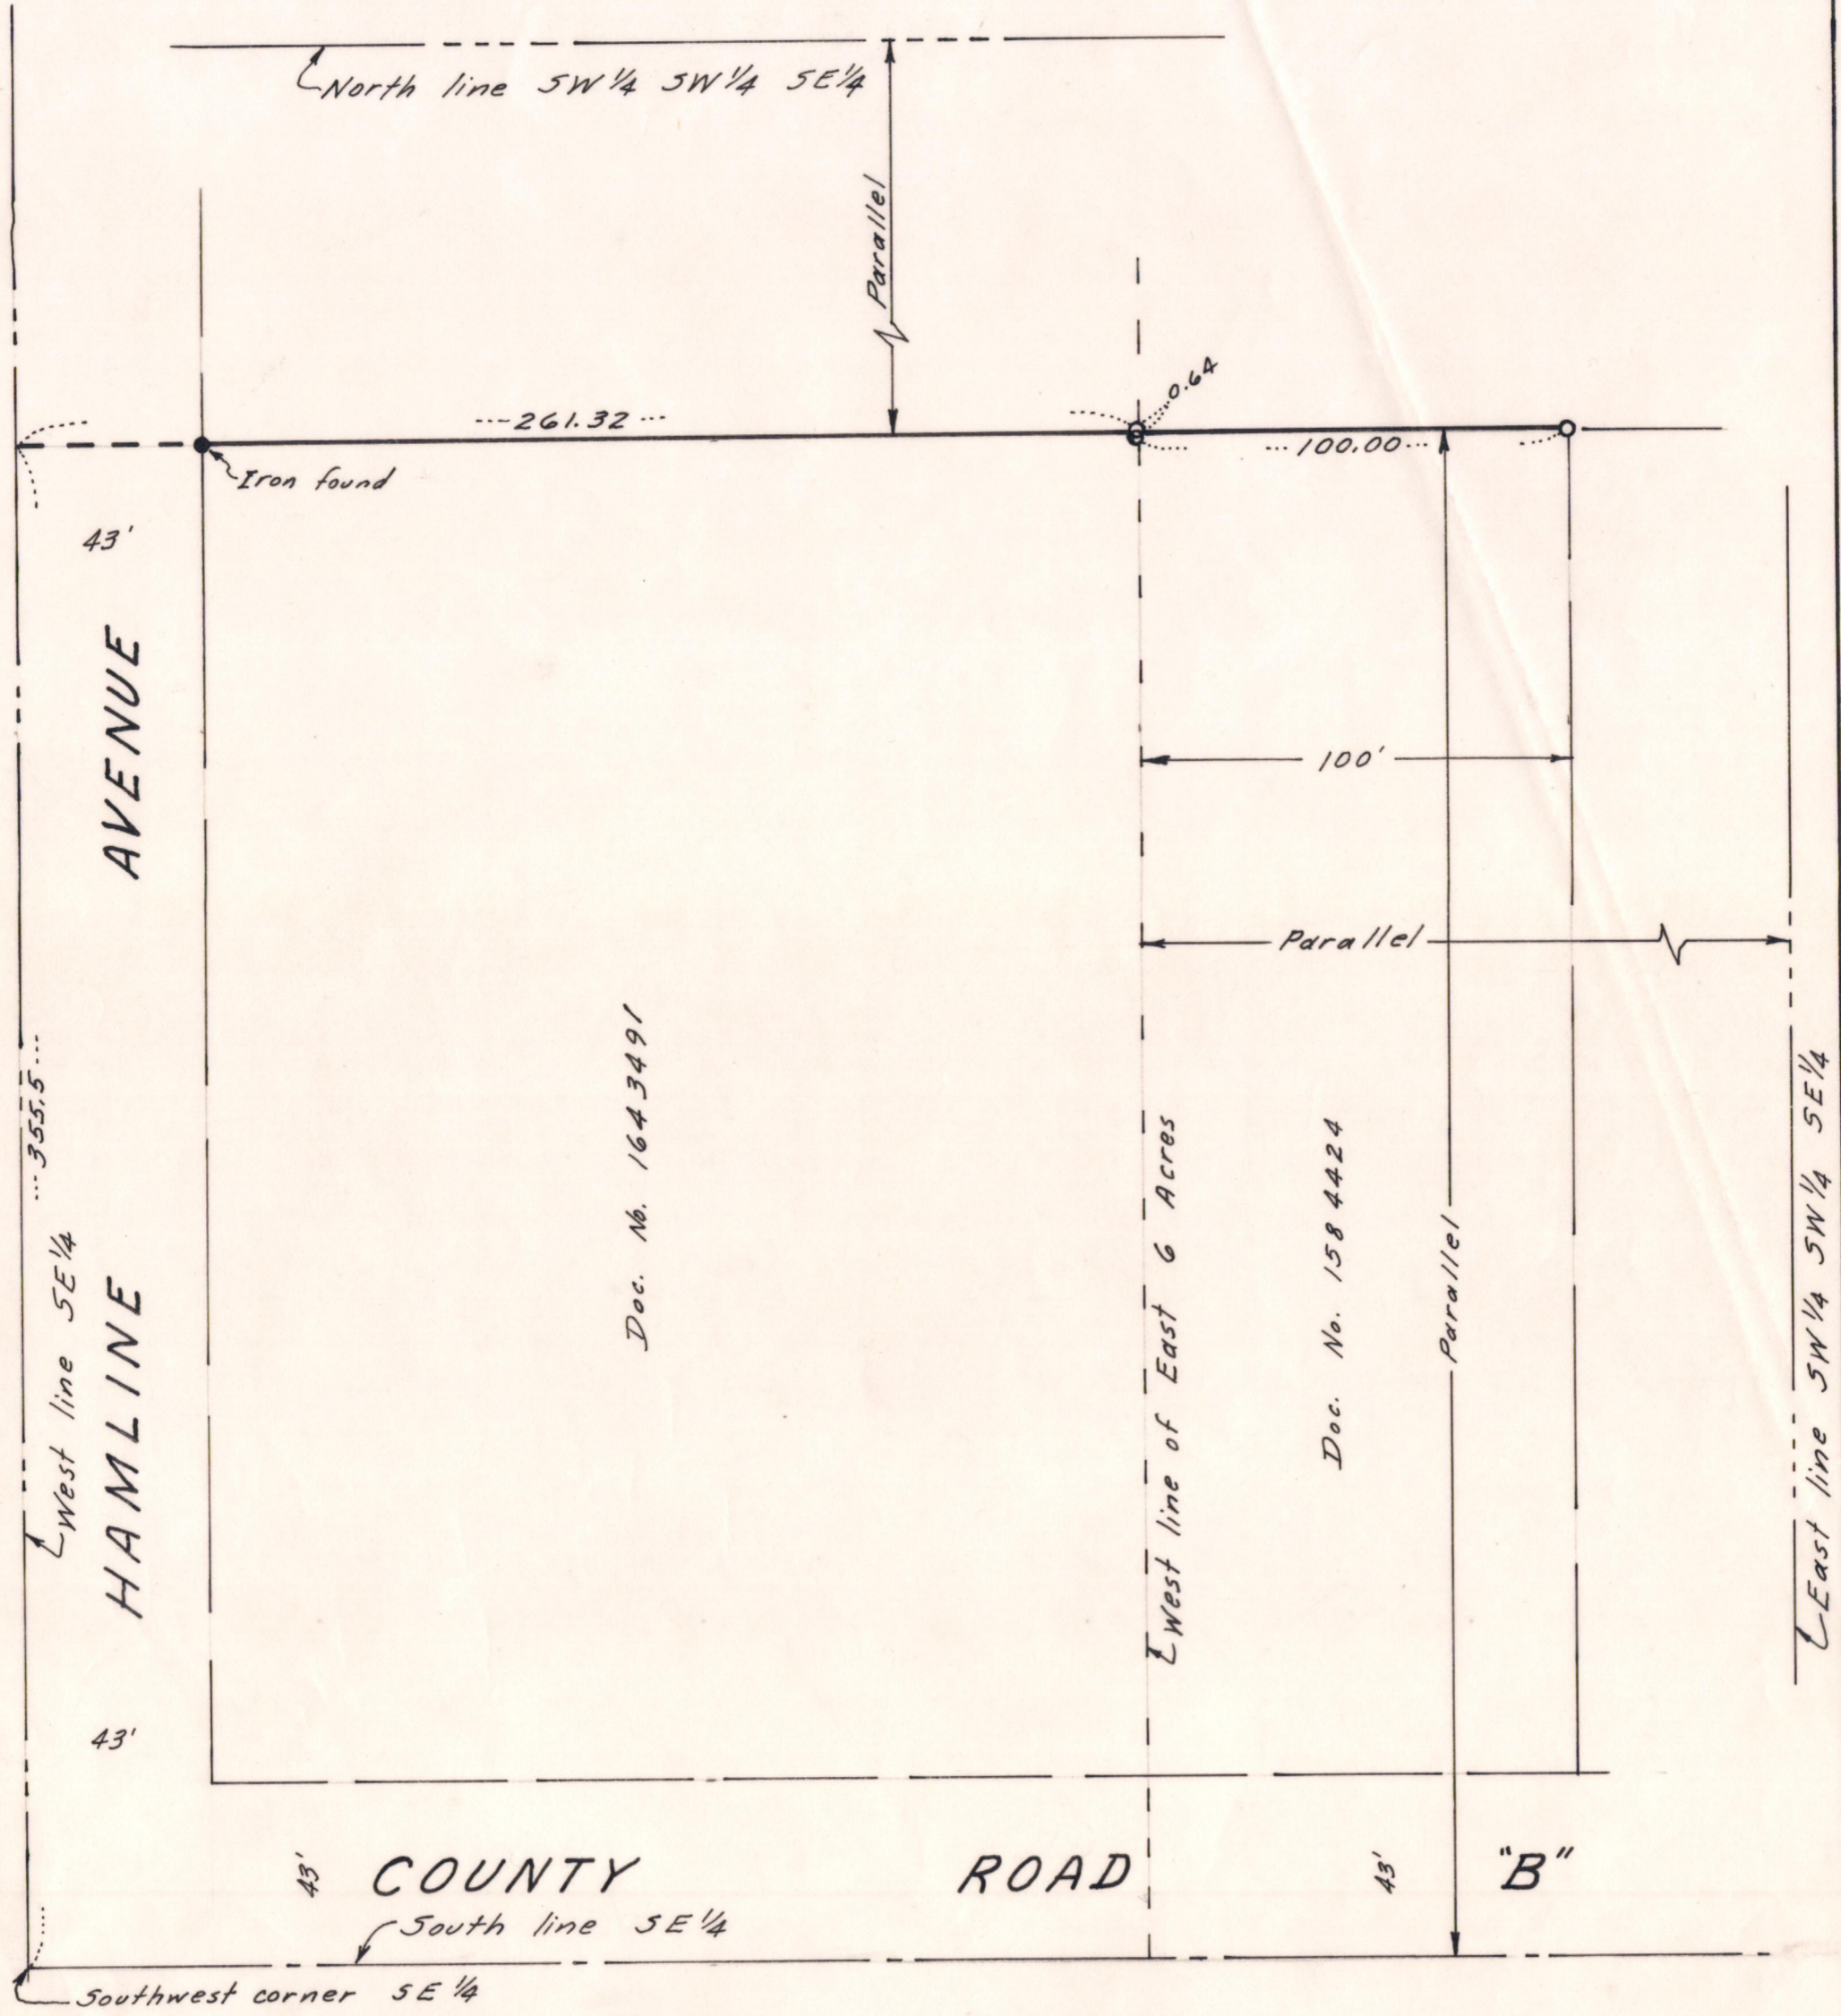

o Indicate iron bar and cap stamped "Ramsey County."

Scale: 1" = 40'

I hereby certify that this survey was prepared by me and that I am a duly Registered Land Surveyor under the laws of the State of Minnesota.

Ronald F. Meyer

Reg. No. 9051

Date:

June 6, 1984