SW 28 30 23

Certificate of Survey

From the office of

GEORGI- SCHMIDT & ASSOC. INC.

3092 No. Lexington Ave., Roseville, Mn. 55113
LAND SURVEYING
483-4408

I Hereby Certify that this plat shows a survey made by me of the property described on this plat, and that the corners are correctly placed as shown,

Job Number: 1580

Surveyed For Roy Wilbee
Date April 30, 1984
Scale 1" = 100'

By _____
REGISTERED LAND SURVEYOR
#10459

Description:

Lot 14,
Rohleder's Home and Garden Acres,
Ramsey County, Minnesota.
Subject to easements.

*used Record plat angles & distances
Various other irons do not agree with
irons shown & found.

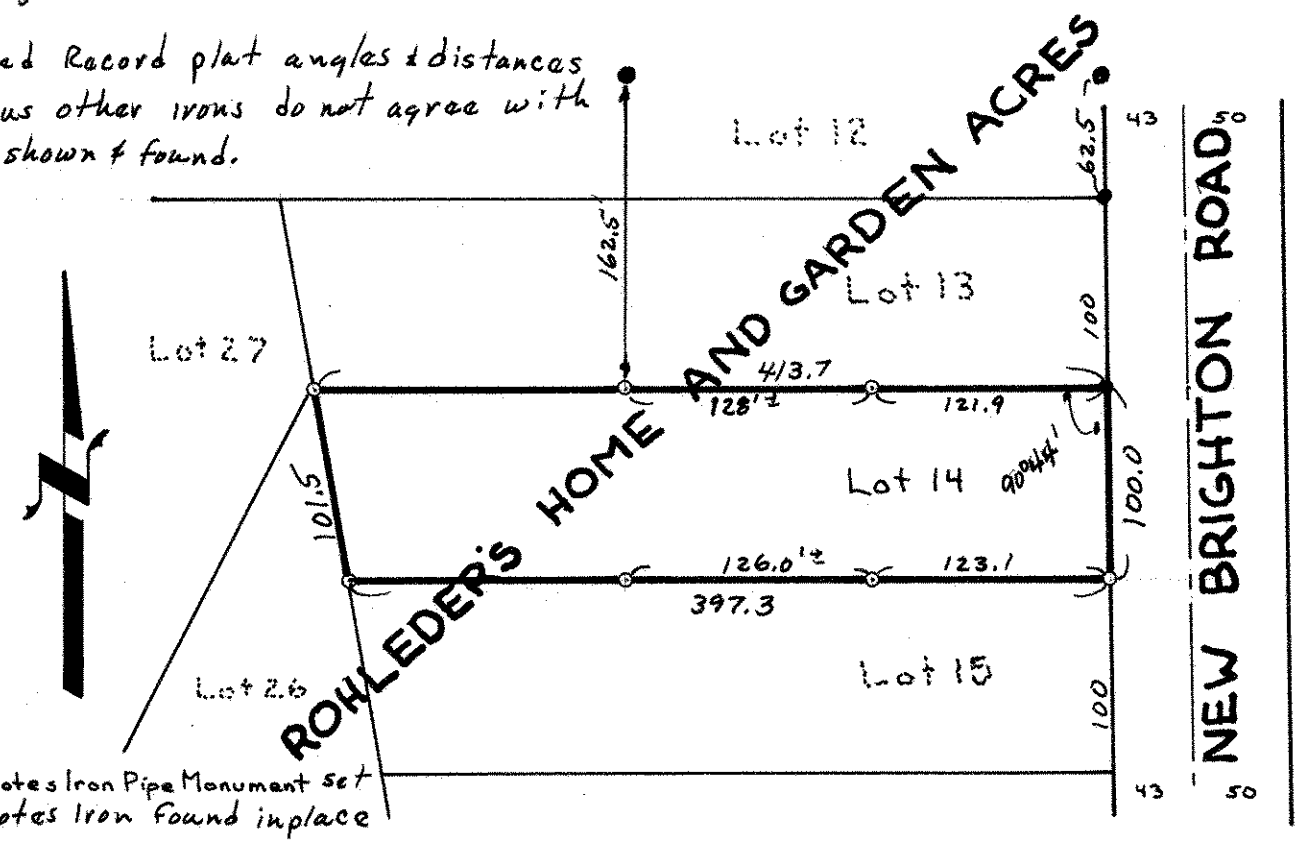

○ Denotes Iron Pipe Monument set
● Denotes Iron Found inplace