SW 20 30 22

Certificate of Survey

From the office of

GEORGI- SCHMIDT & ASSOC. INC.

3092 No. Lexington Ave., Roseville, Mn. 55113

LAND SURVEYING

483-4408

I Hereby Certify that this plat shows a survey made by me of the property described on this plat, and that the corners are correctly placed as shown,

Job Number: 1638

Surveyed For Joanne Smith Coale Arcanna

Date 7/20/84

Scale 1"=50'

By _____ REGISTERED LAND SURVEYOR

Description:

Lot 1, Block 1, Walkers Oakcrest

Ramsey County, MN.

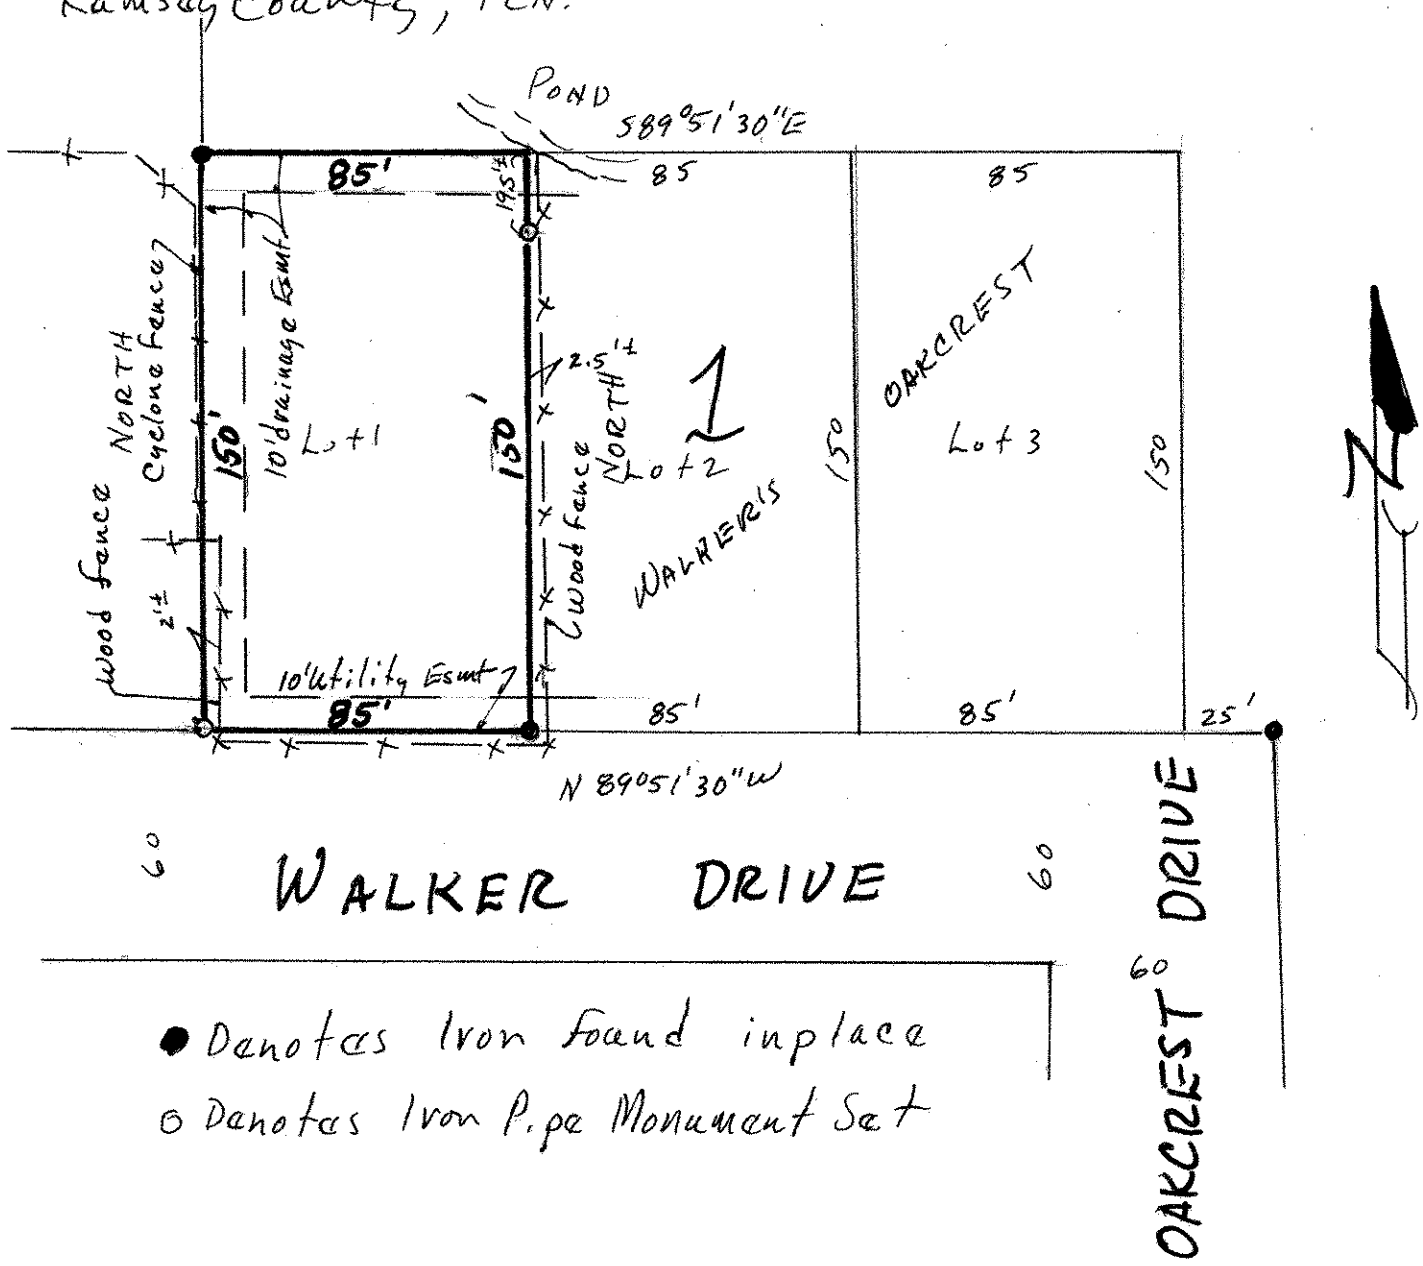

● Denotes Iron found inplace

○ Denotes Iron Pipe Monument Set