NE 5 29 22

Certificate of Survey

From the office of

GEORGI- SCHMIDT & ASSOC. INC.

3092 No. Lexington Ave., Roseville, Mn. 55113
LAND SURVEYING
483-4408

I Hereby Certify that this plat shows a survey made by me of the property described on this plat, and that the corners are correctly placed as shown,

Job Number: 1606

Surveyed For Thomas Picha
Date 6/2/84 - 6/29/84 9/12/84 Add Esm'ts 3/11/85 15' Esmt
Scale 1" = 40'

By _____
REGISTERED LAND SURVEYOR

Description:
The South 75.0 feet of the North 931.22 feet of Lot 12, Auditor's Subdivision No. 43, except the West 33 feet thereof for street. Subject to easements.

Ramsey County, Minnesota

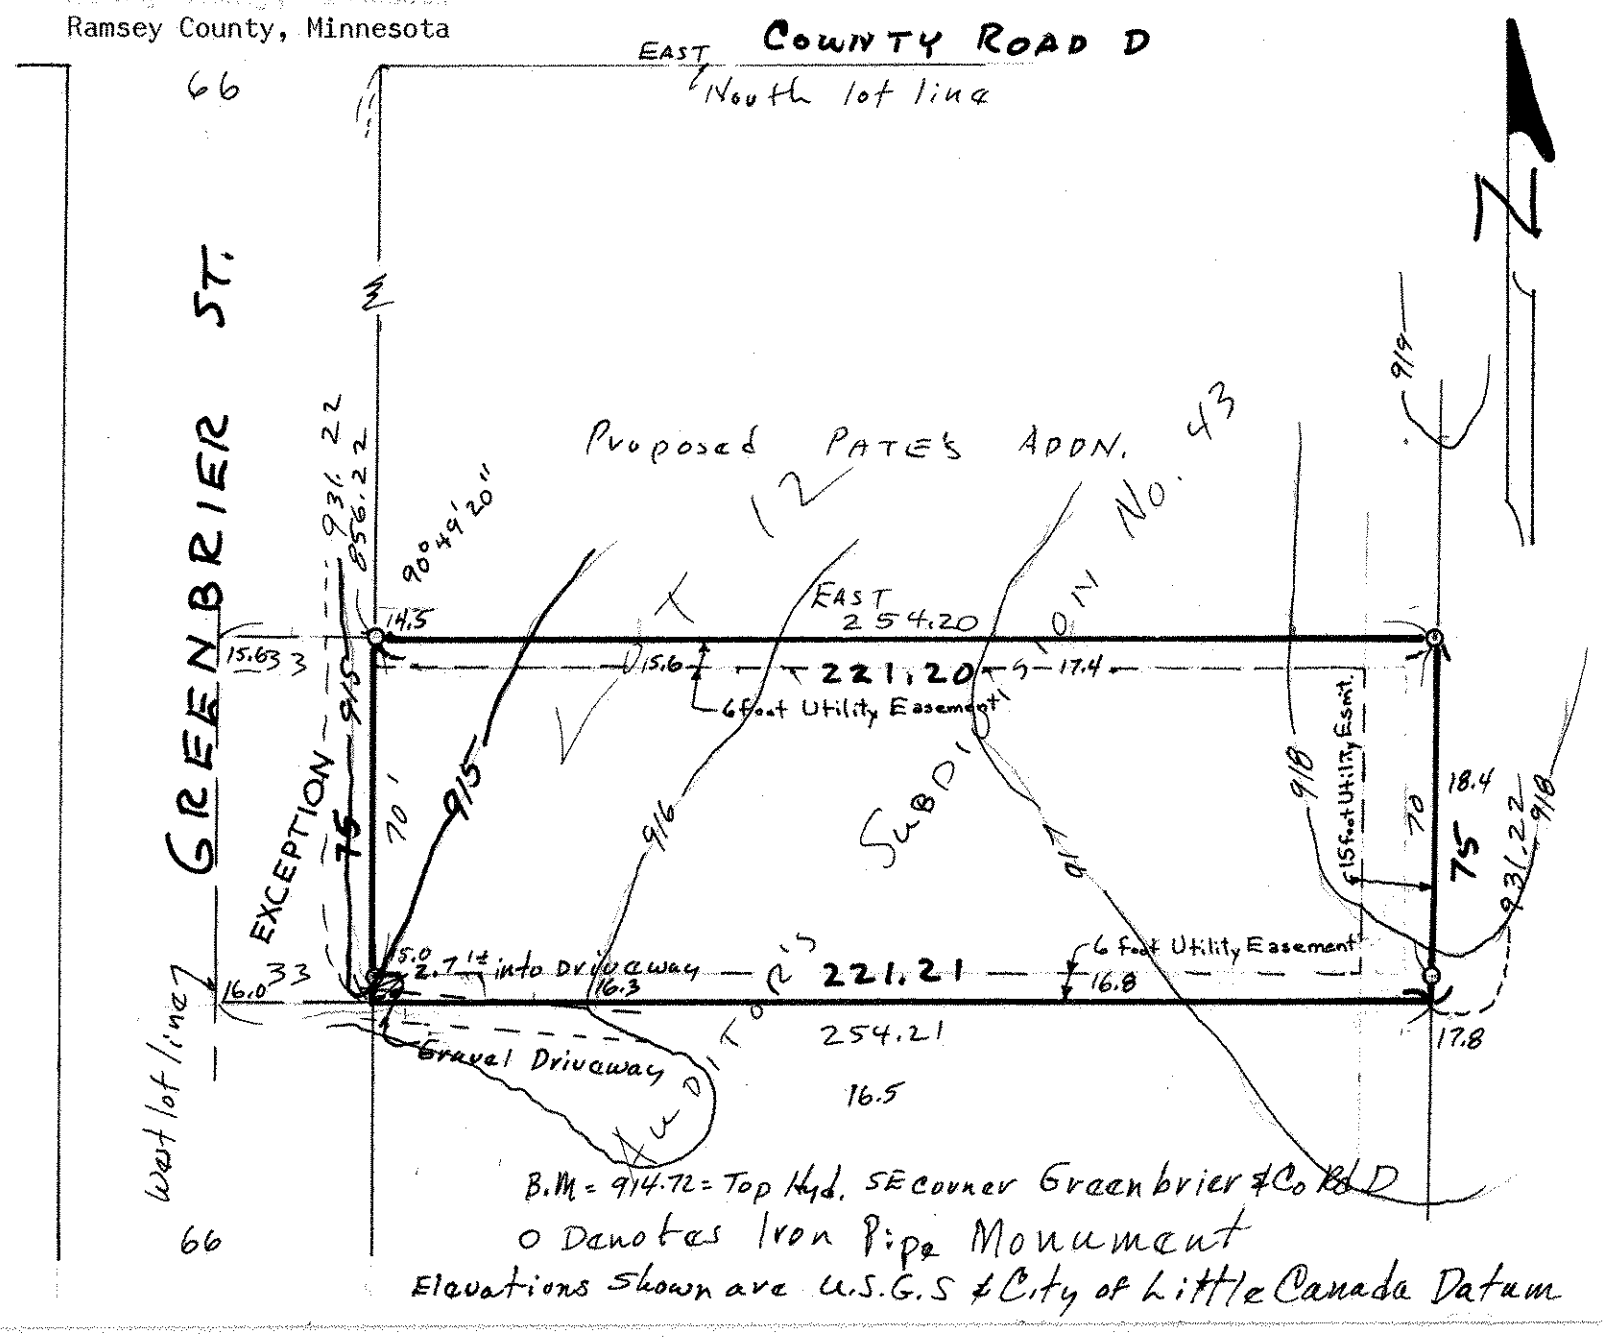

B.M = 914.72 = Top Hyd. SE corner Greenbrier & Co Rd D
o Denotes Iron Pipe Monument
Elevations shown are U.S.G.S & City of Little Canada Datum