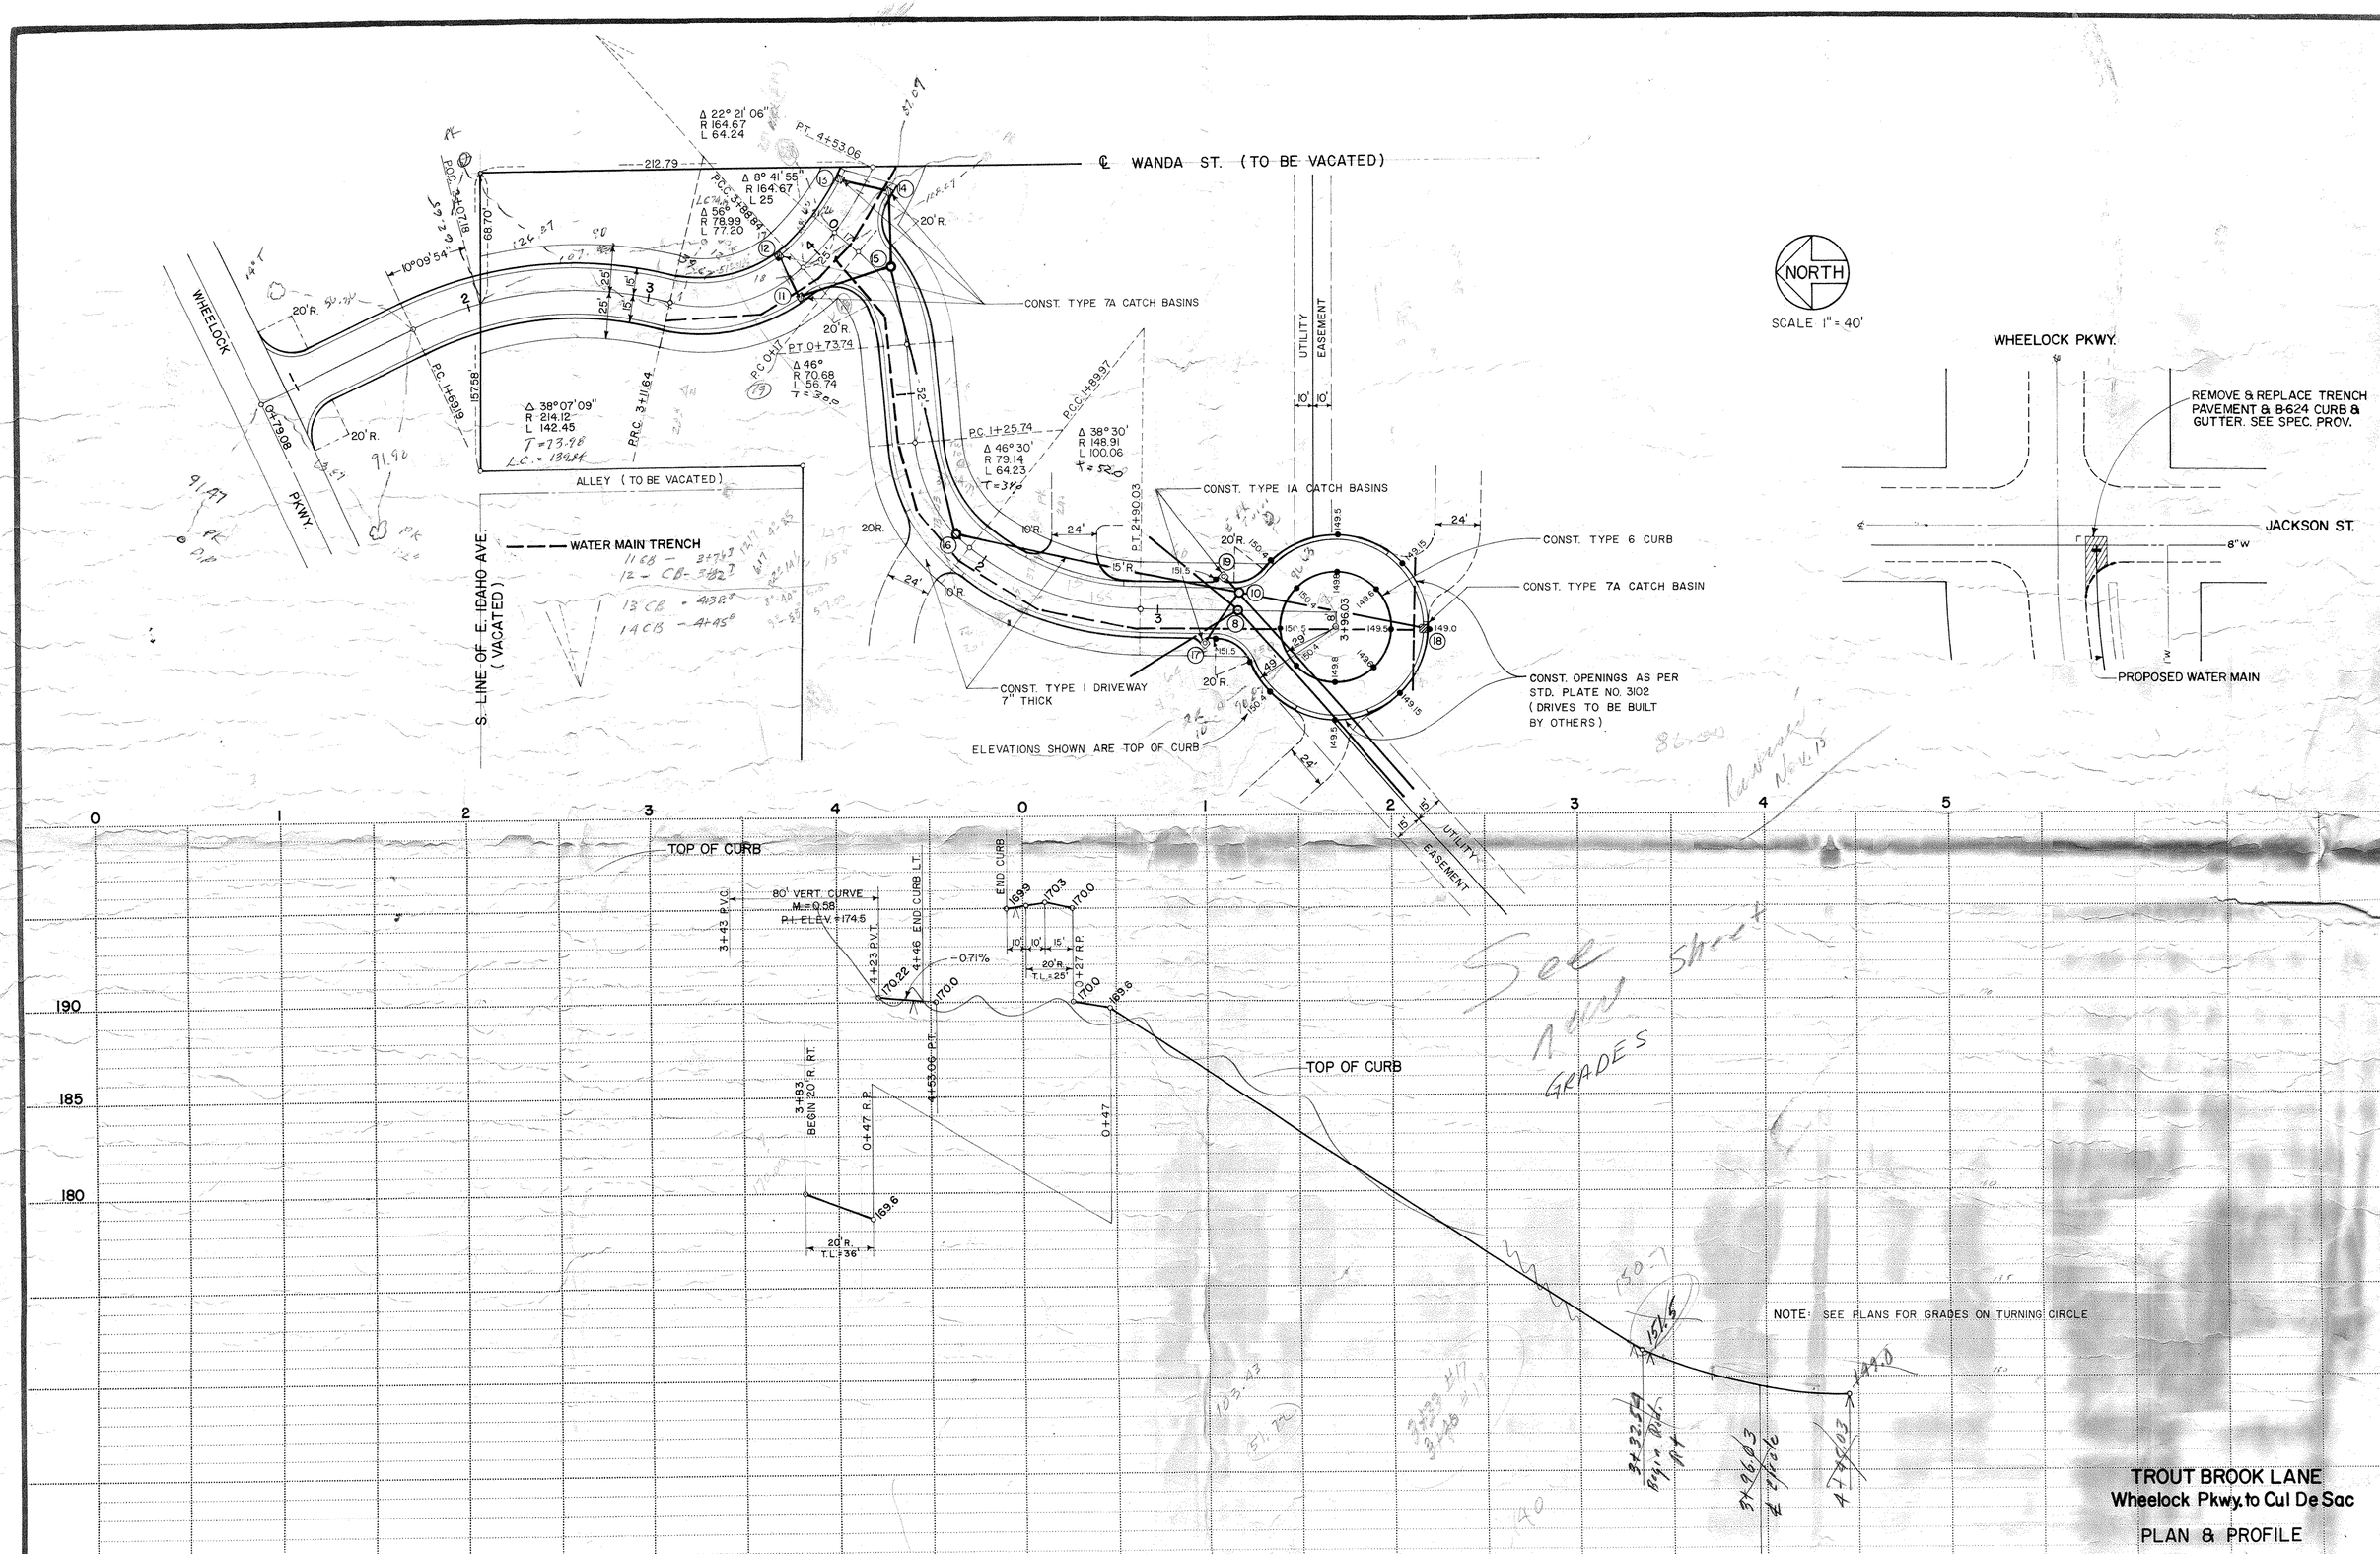

TROUT BROOK LANE
Wheelock Pkwy. to Cul De Sac
PLAN & PROFILE

P-0967B DR. 12 | TROUT BROOK LANE DRG. NO. 1274 | 1/1

CITY PROJ. NO. 84-P-0967 B

SHEET 1 OF 1 SHEETS