SE 1/4 10 30 22

Certificate of Survey

From the office of

GEORGI- SCHMIDT & ASSOC. INC.

3092 No. Lexington Ave., Roseville, Mn. 55113

LAND SURVEYING

483-4408

I Hereby Certify that this plat shows a survey made by me of the property described on this plat, and that the corners are correctly placed as shown,

"House Location"

Job Number: 1746

Surveyed For Jack Nuebel

Date 2/15/85

Scale 1" = 30'

By _____ REGISTERED LAND SURVEYOR

Description:

Lot 4, Block 1,
Fernbrook Second Addition
Ramsey County, Minnesota

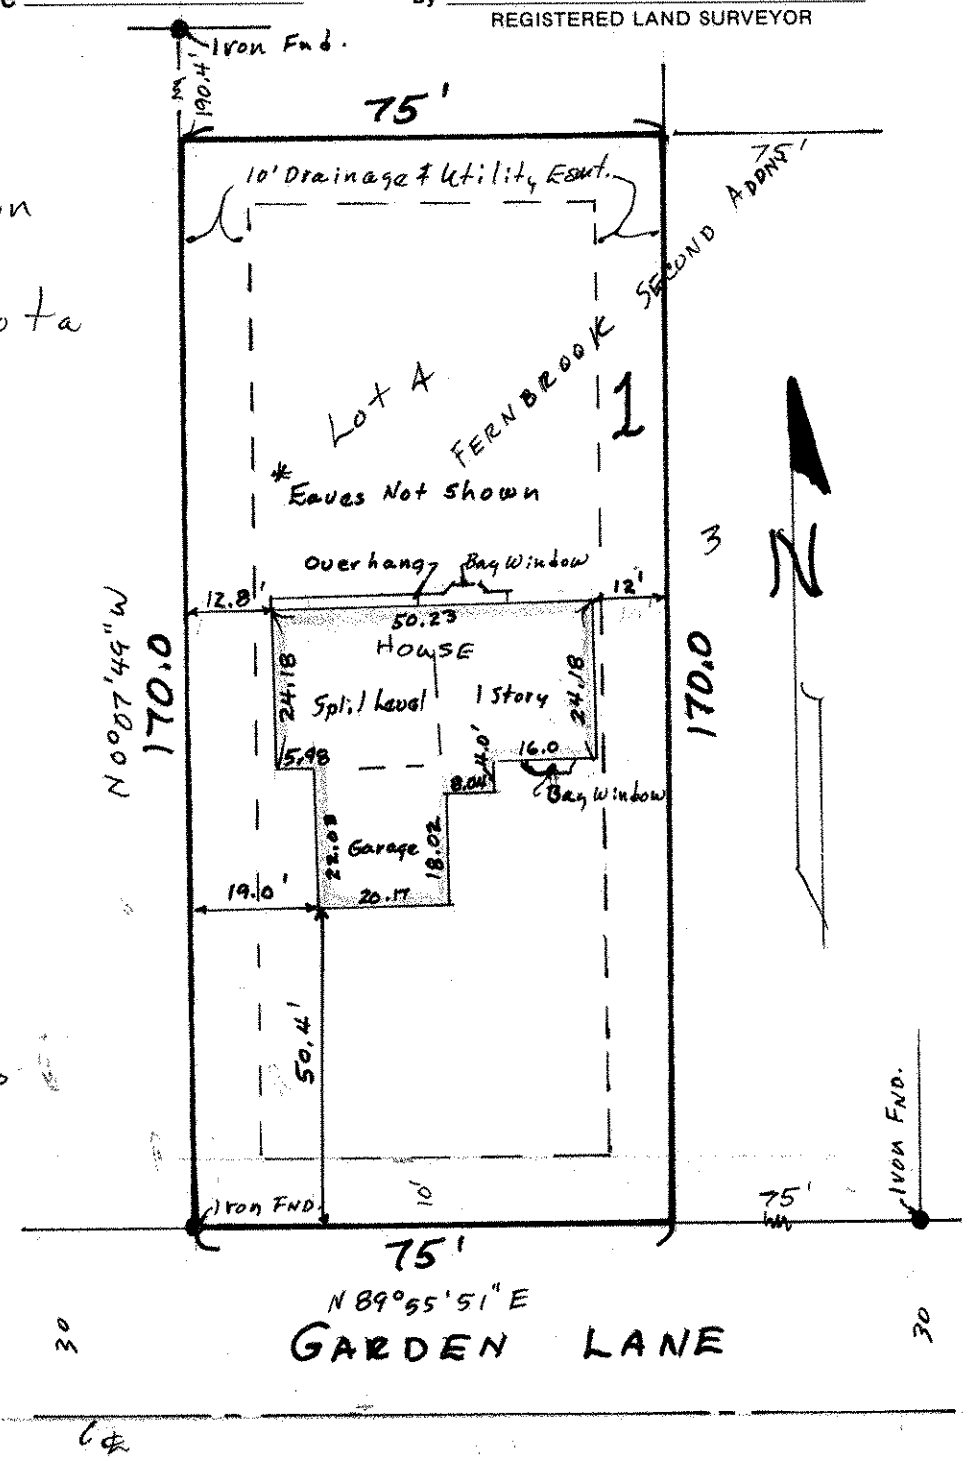

*Distance & Clearances shown to wood above foundation.