SW 29 30 22

Certificate of Survey

From the office of

GEORGI- SCHMIDT & ASSOC. INC.

3092 No. Lexington Ave., Roseville, Mn. 55113

LAND SURVEYING

483-4408

I Hereby Certify that this plat shows a survey made by me of the property described on this plat, ~~and that the corners are correctly placed as shown,~~ that this survey was done by me or under my direct supervision; and that I am a duly registered Land Surveyor under the Laws of the State of Minnesota.

Job Number: 1783

Surveyed For Charles Brunet

Date April 17, 1985

Scale 1" = 40'

By _____
REGISTERED LAND SURVEYOR
#10459

Description:

Lot 10, Block 1, Brunet Addition except that triangular part thereof lying Southeasterly of the following described line; beginning at the point of intersection of the Southeasterly line of said Lot 10 and the North line of the South 15 feet of Lot 9, Block 1, said Bruntet Addition; thence Southwesterly in a straight line to the Northwest corner of Lot 3, Block 1, said Brunet Addition and there terminating.
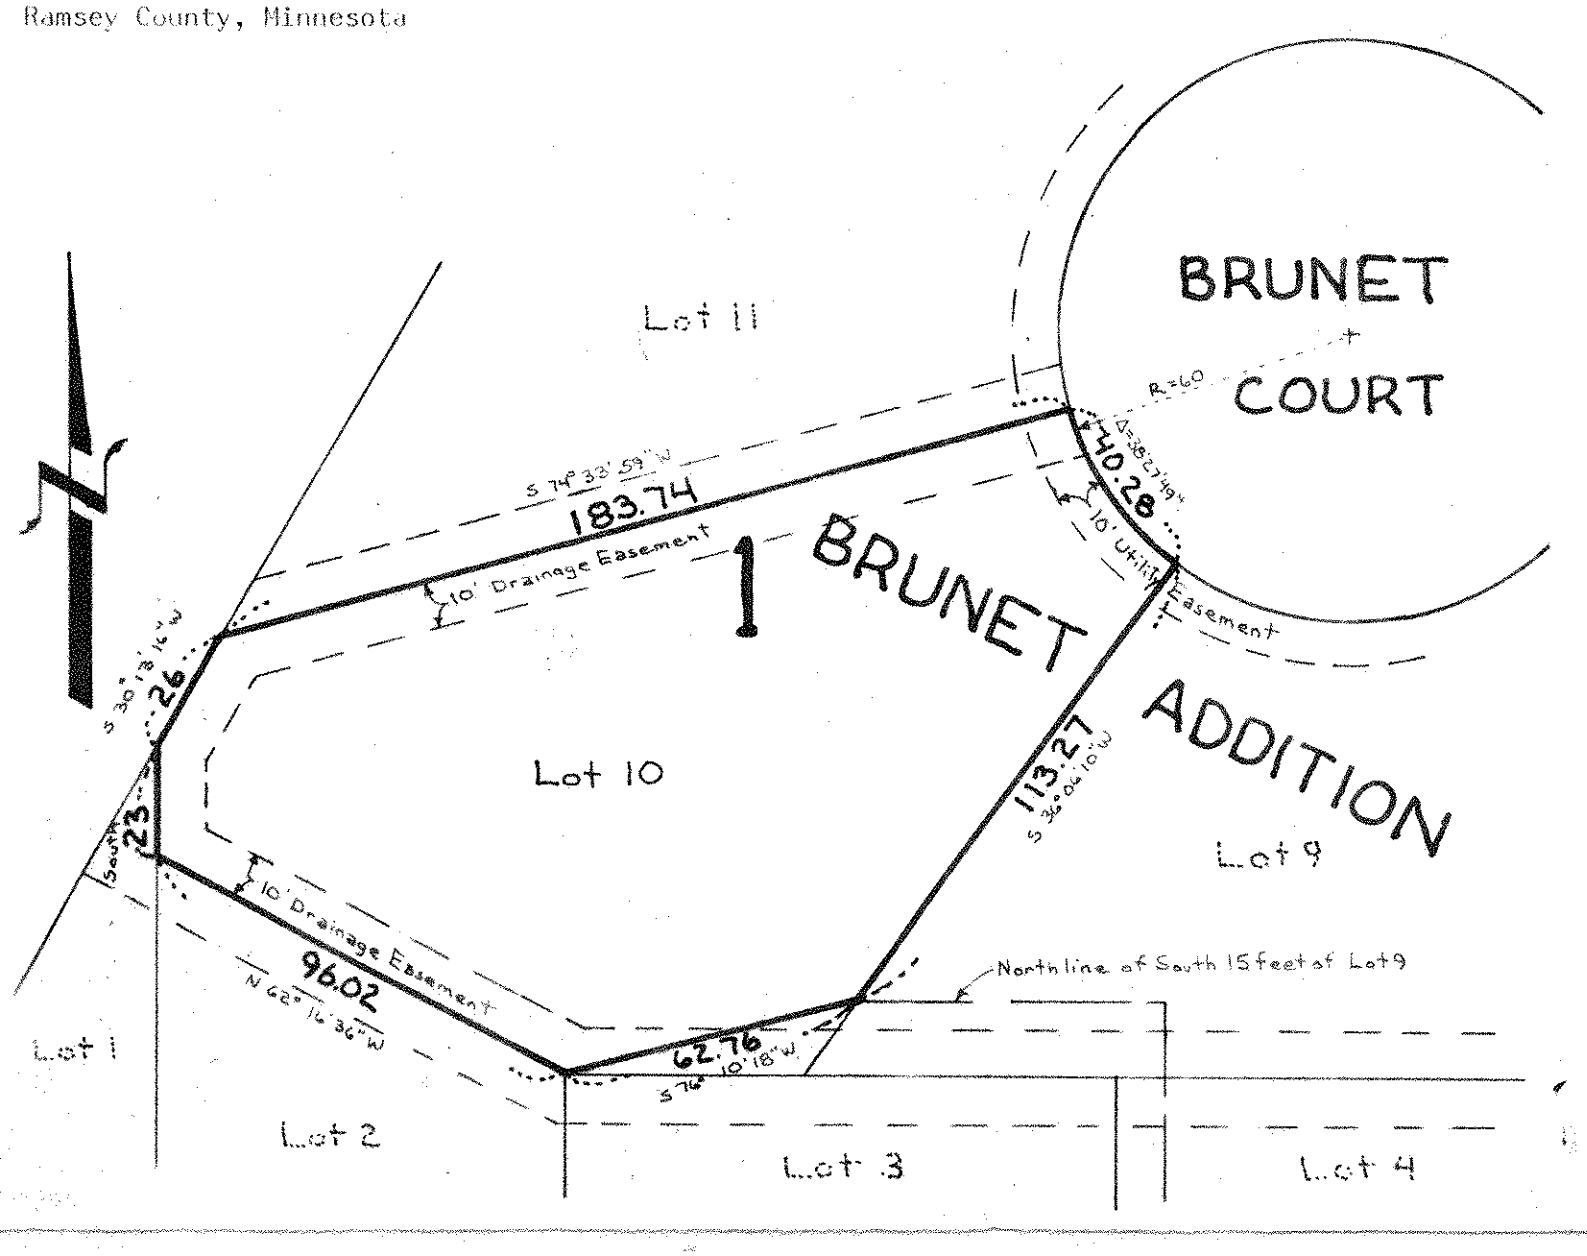
Ramsey County, Minnesota