NW 10 29 23

Certificate of Survey

From the office of

GEORGI- SCHMIDT & ASSOC. INC.

3092 No. Lexington Ave., Roseville, Mn. 55113

LAND SURVEYING

483-4408

I Hereby Certify that this plat shows a survey made by me of the property described on this plat, ~~and that the corners are correctly placed as shown~~, and that any locations shown are correct.

Job Number: 1752

Surveyed For Hamline Townoffices

Date February 25, 1985

Scale 1" = 10"

By _____

REGISTERED LAND SURVEYOR

Description:
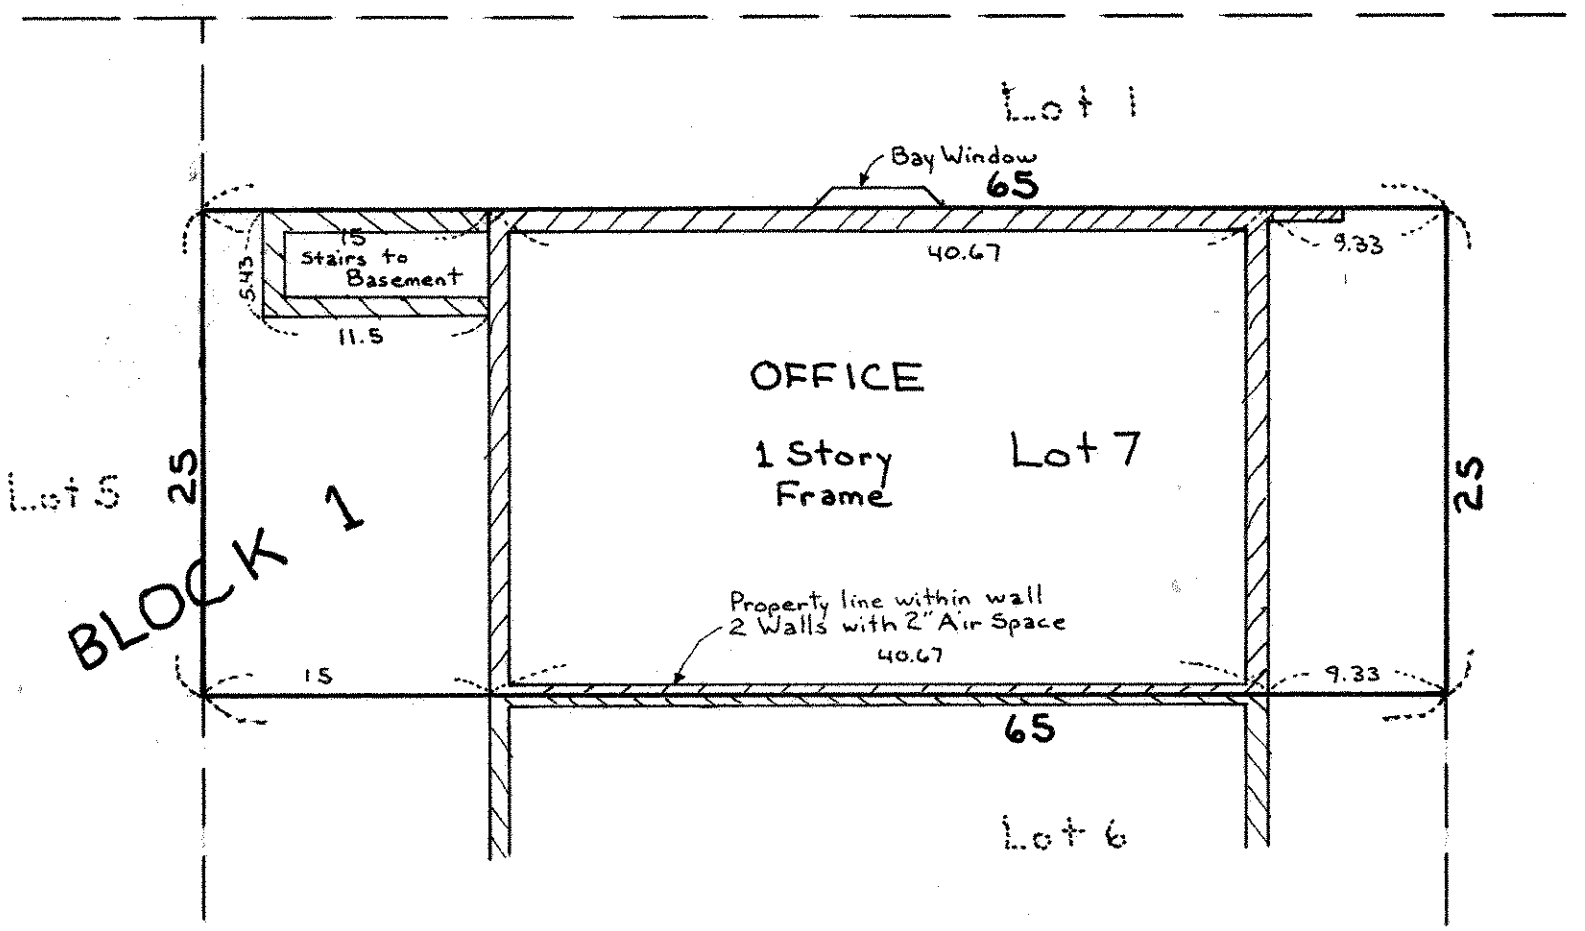
Lot 7,
Block 1,
Hamline Townoffice Plaza,
Ramsey County, Minnesota.