NW 6 29 22

Certificate of Survey

From the office of

GEORGI- SCHMIDT & ASSOC. INC.

3092 No. Lexington Ave., Roseville, Mn. 55113

LAND SURVEYING

483-4408

I Hereby Certify that this plat shows a survey made by me of the property described on this plat, ~~and that the corners are correctly placed as shown~~,

Job Number: 1767

Surveyed For Art Ryan

Date 3/20/85

Scale 1" = 100'

By _____
REGISTERED LAND SURVEYOR

Description:

The Northerly 140.0 feet of Lot 1, Block 4, Ryan Industrial Park lying West of the East 250 feet of said Lot 1, as measured at right angles to the Northerly and Easterly lines thereof. Subject to easements of record.
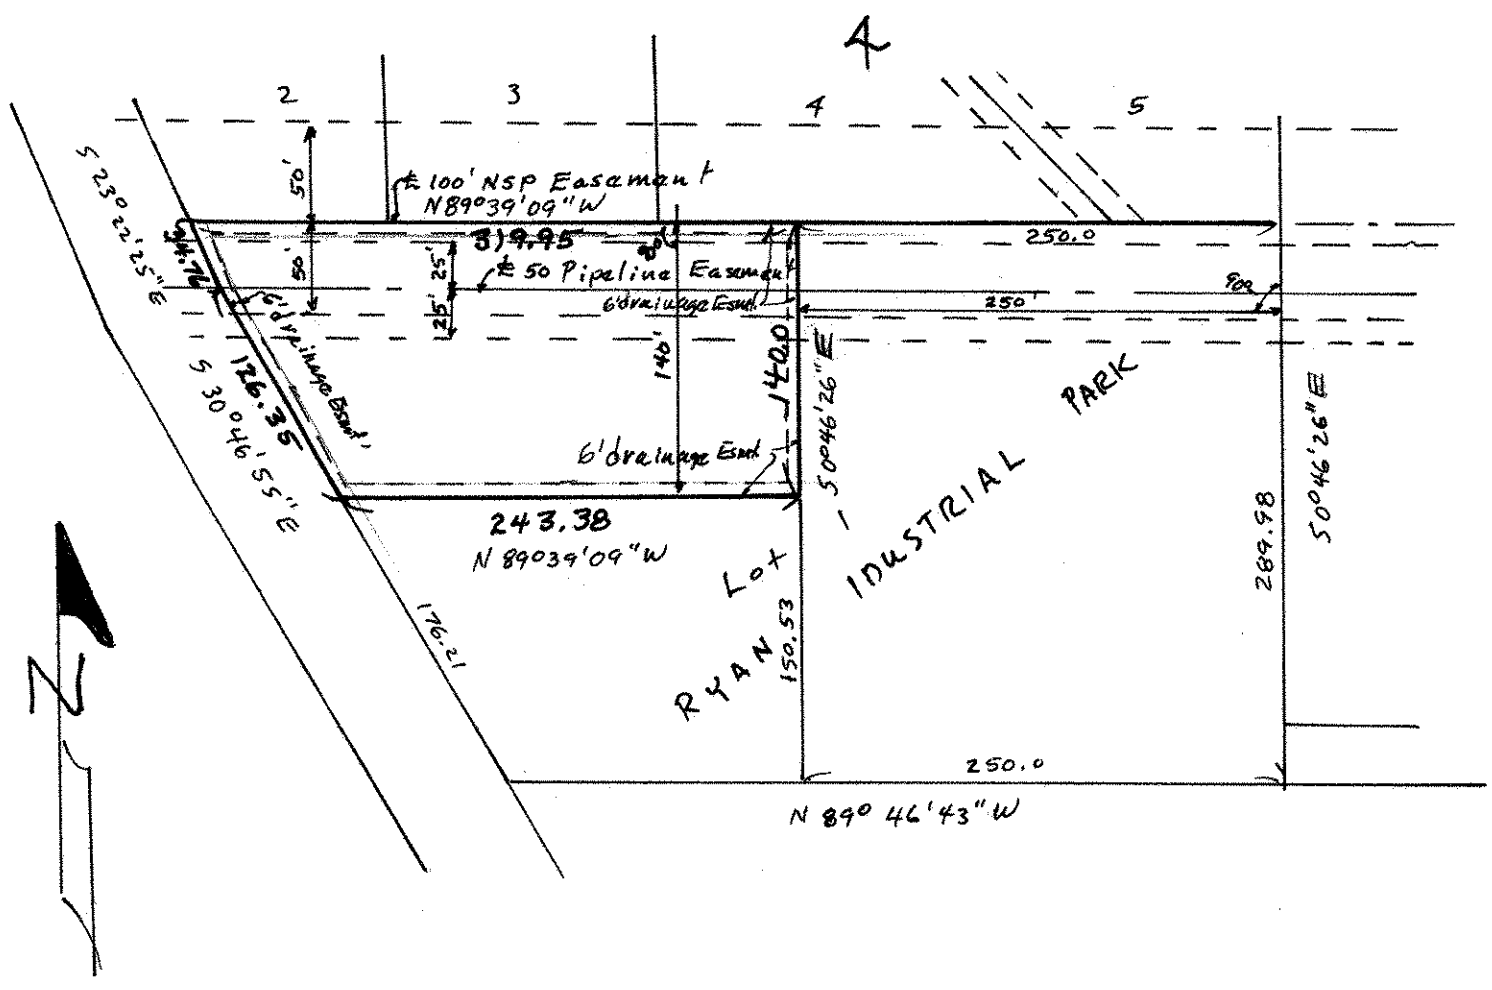
Ramsey County, Minnesota