NORTH LAND SURVEYING CO.
Two Blocks North of Hwy 694 & Rice St

Curt Leavitt, R.L.S.
3636 Rustic Place
Shoreview, Minn 55126
483 - 3101

CERTIFICATE OF SURVEY

For: HERBERT and MARLENE SELVOG

DESCRIPTION OF PROPERTY: "Lot 4, Block 2, WHITE OAKS PARK"

SCALE
1 inch = 40 feet

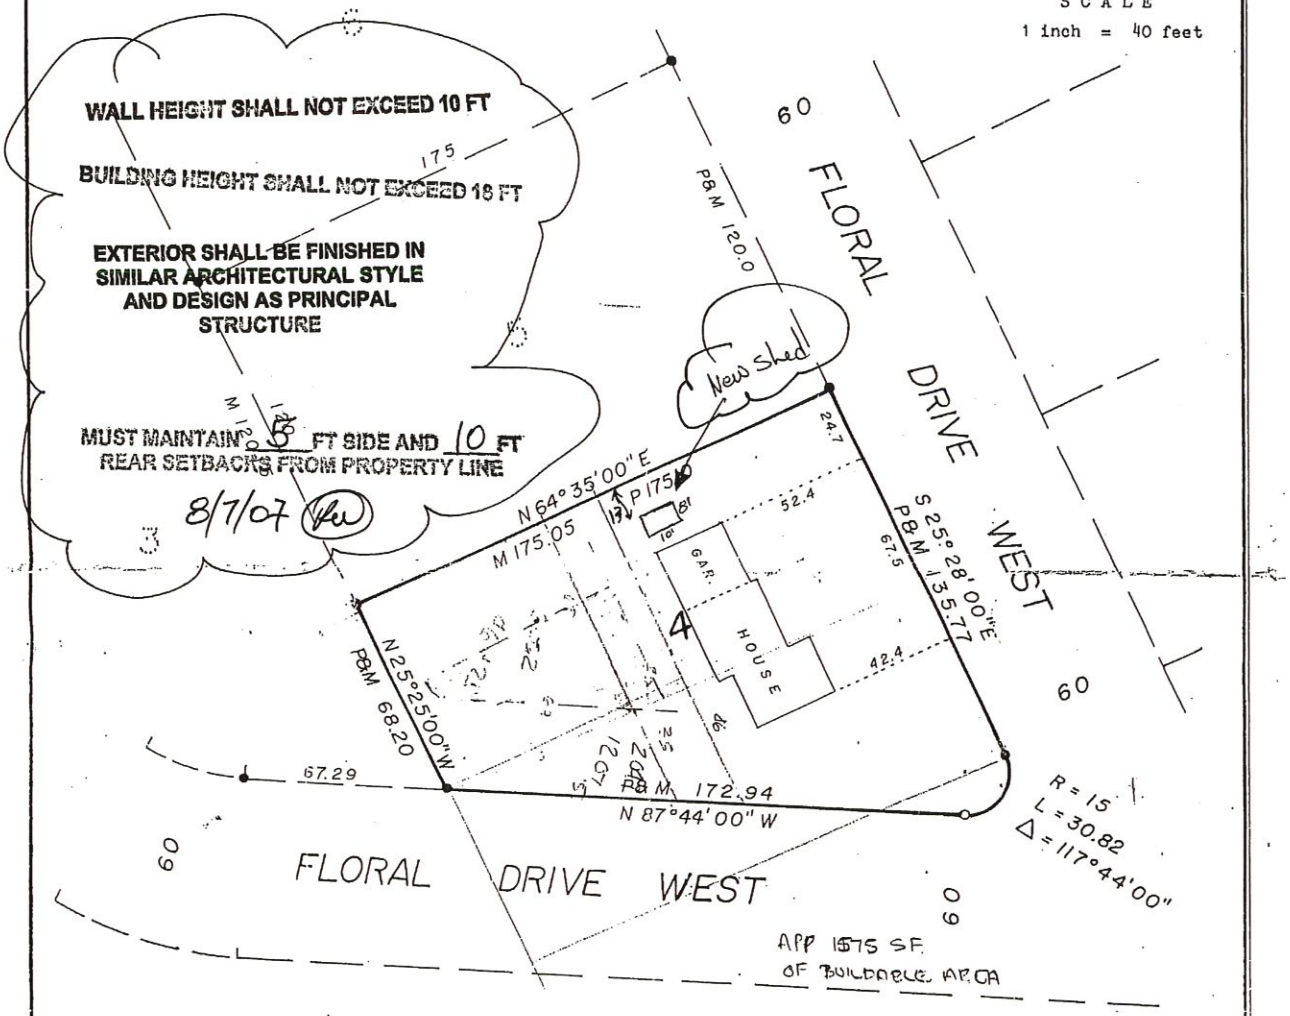

NOTES

1. Bearings are assumed.
2. ● indicates found iron monument.
3. O indicates iron pipe set with R.L.S. cap #14946.
4. M indicates measured values.
5. Plat values are preceded by the letter P or by no letter.

I hereby certify that this survey, plan, or report was prepared by me or under my direct supervision and that I am a duly Registered Land Surveyor under the laws of the State of Minnesota.

Curt Leavitt

Date Sept 30, 1985 Reg. No. 14946

10,000
8232 sq ft

75-F
125-R

375 Floral

17748
sq ft