SE 8 29 23

Certificate of Survey

From the office of

GEORGI- SCHMIDT & ASSOC. INC.

3092 No Lexington Ave., Roseville, Mn. 55113
LAND SURVEYING
483-4408

I Hereby Certify that this plat shows a survey made by me of the property described on this plat and that the corners are correctly placed as shown, that this survey, plat or report was prepared by me, or under my direction; and that I am a duly registered Land Surveyor under the Laws of the State of Minnesota.

Job Number: 3087
Surveyed For Robert Lewis
Date 7/3/86
Scale 1"=60'

By _____
REGISTERED LAND SURVEYOR
Mn. Registration No. 10459

DESCRIPTION: (Not furnished - Parcel A)

The East 100 feet of the North 301 feet of the Southwest quarter of the Southeast quarter of Section 8, T29N, R23W and the West 99 feet of the North 301 feet of the Southeast quarter of the Southeast quarter of Section 8, T29N, R23W. Subject to easements of record.

Ramsey County, Minnesota

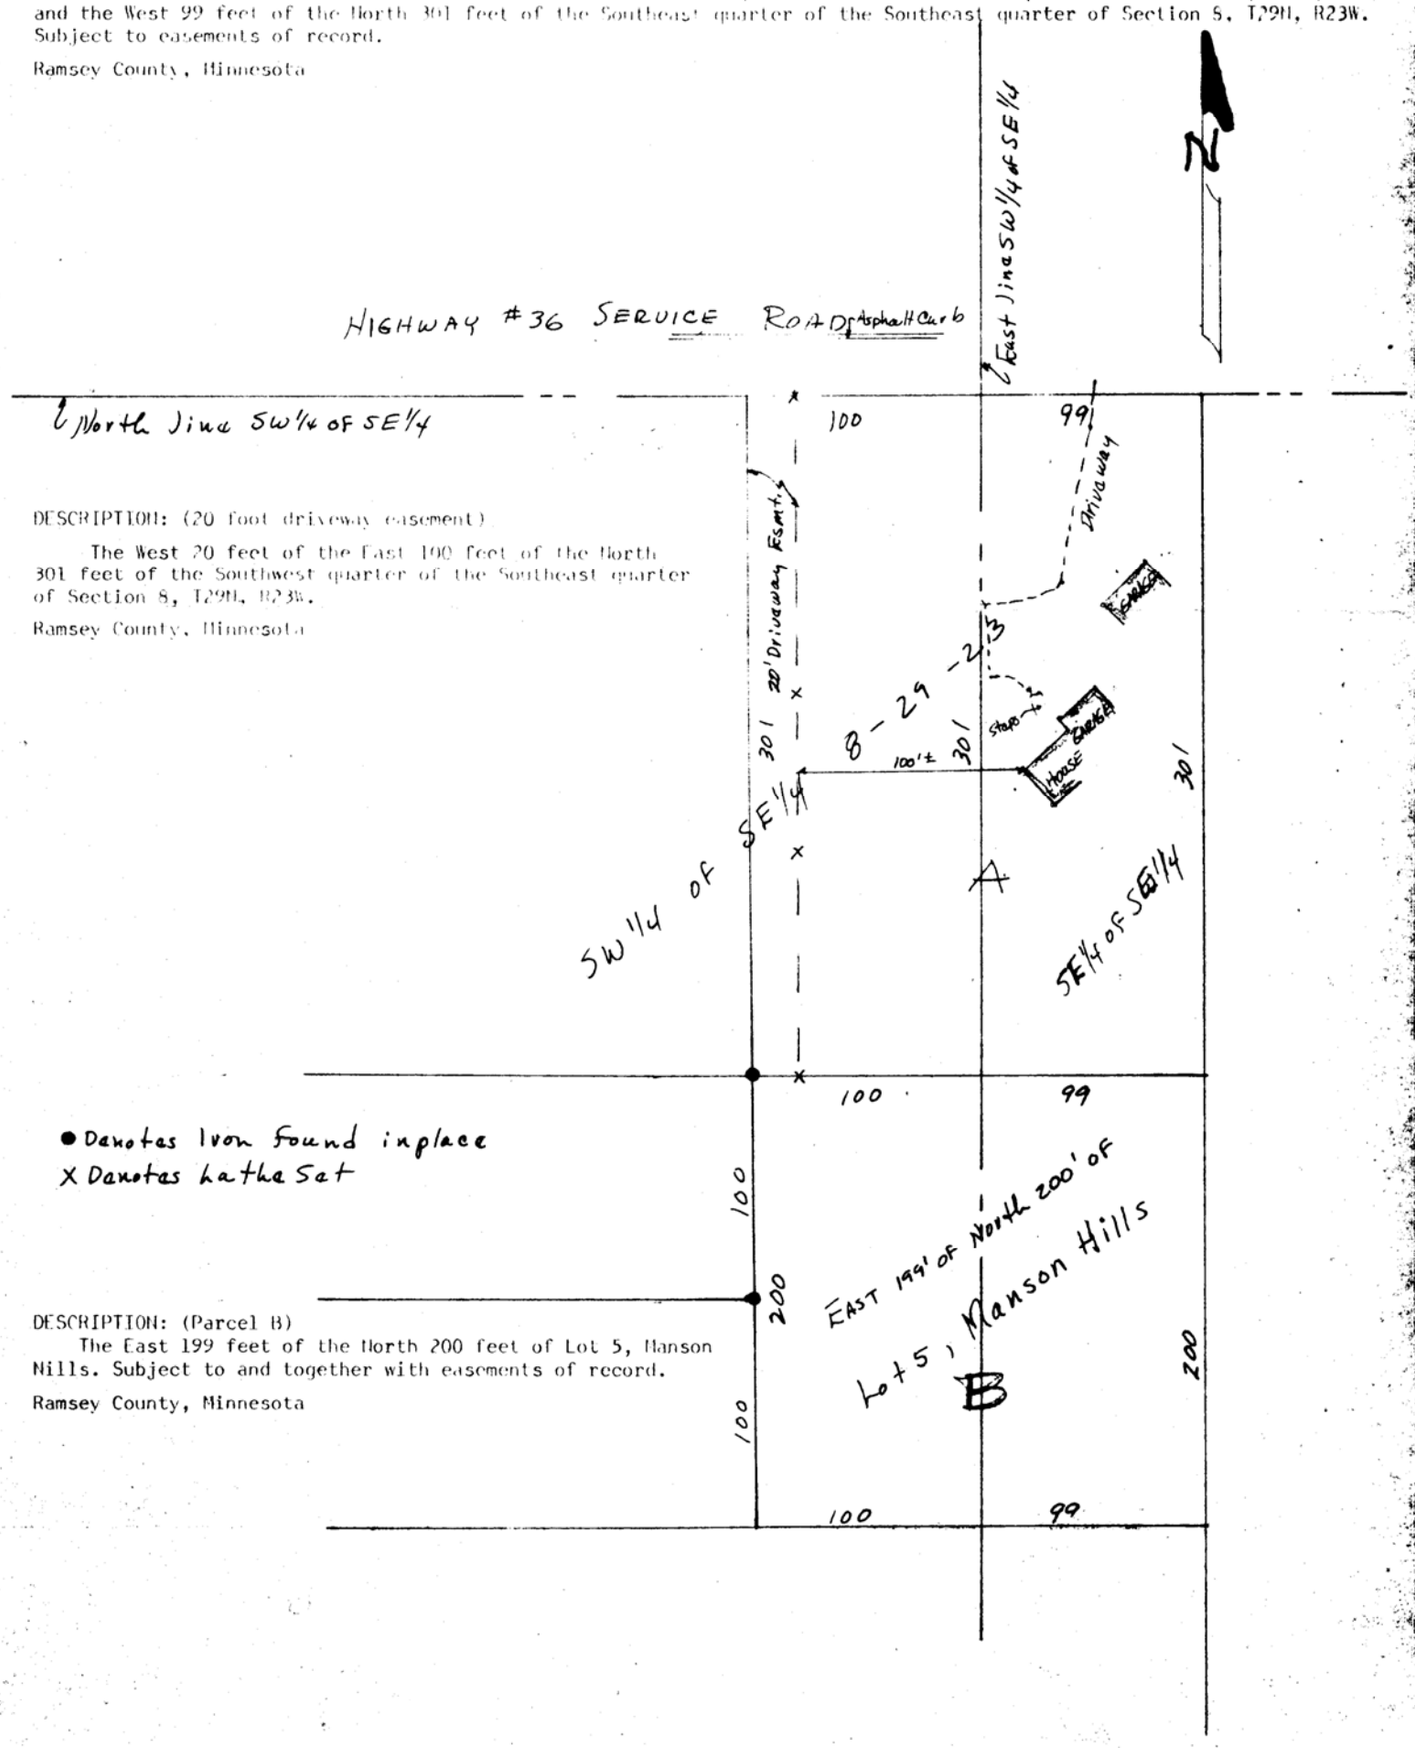

DESCRIPTION: (20 foot driveway easement)

The West 20 feet of the East 100 feet of the North 301 feet of the Southwest quarter of the Southeast quarter of Section 8, T29N, R23W.

Ramsey County, Minnesota

DESCRIPTION: (Parcel B)

The East 199 feet of the North 200 feet of Lot 5, Manson Hills. Subject to and together with easements of record.

Ramsey County, Minnesota