
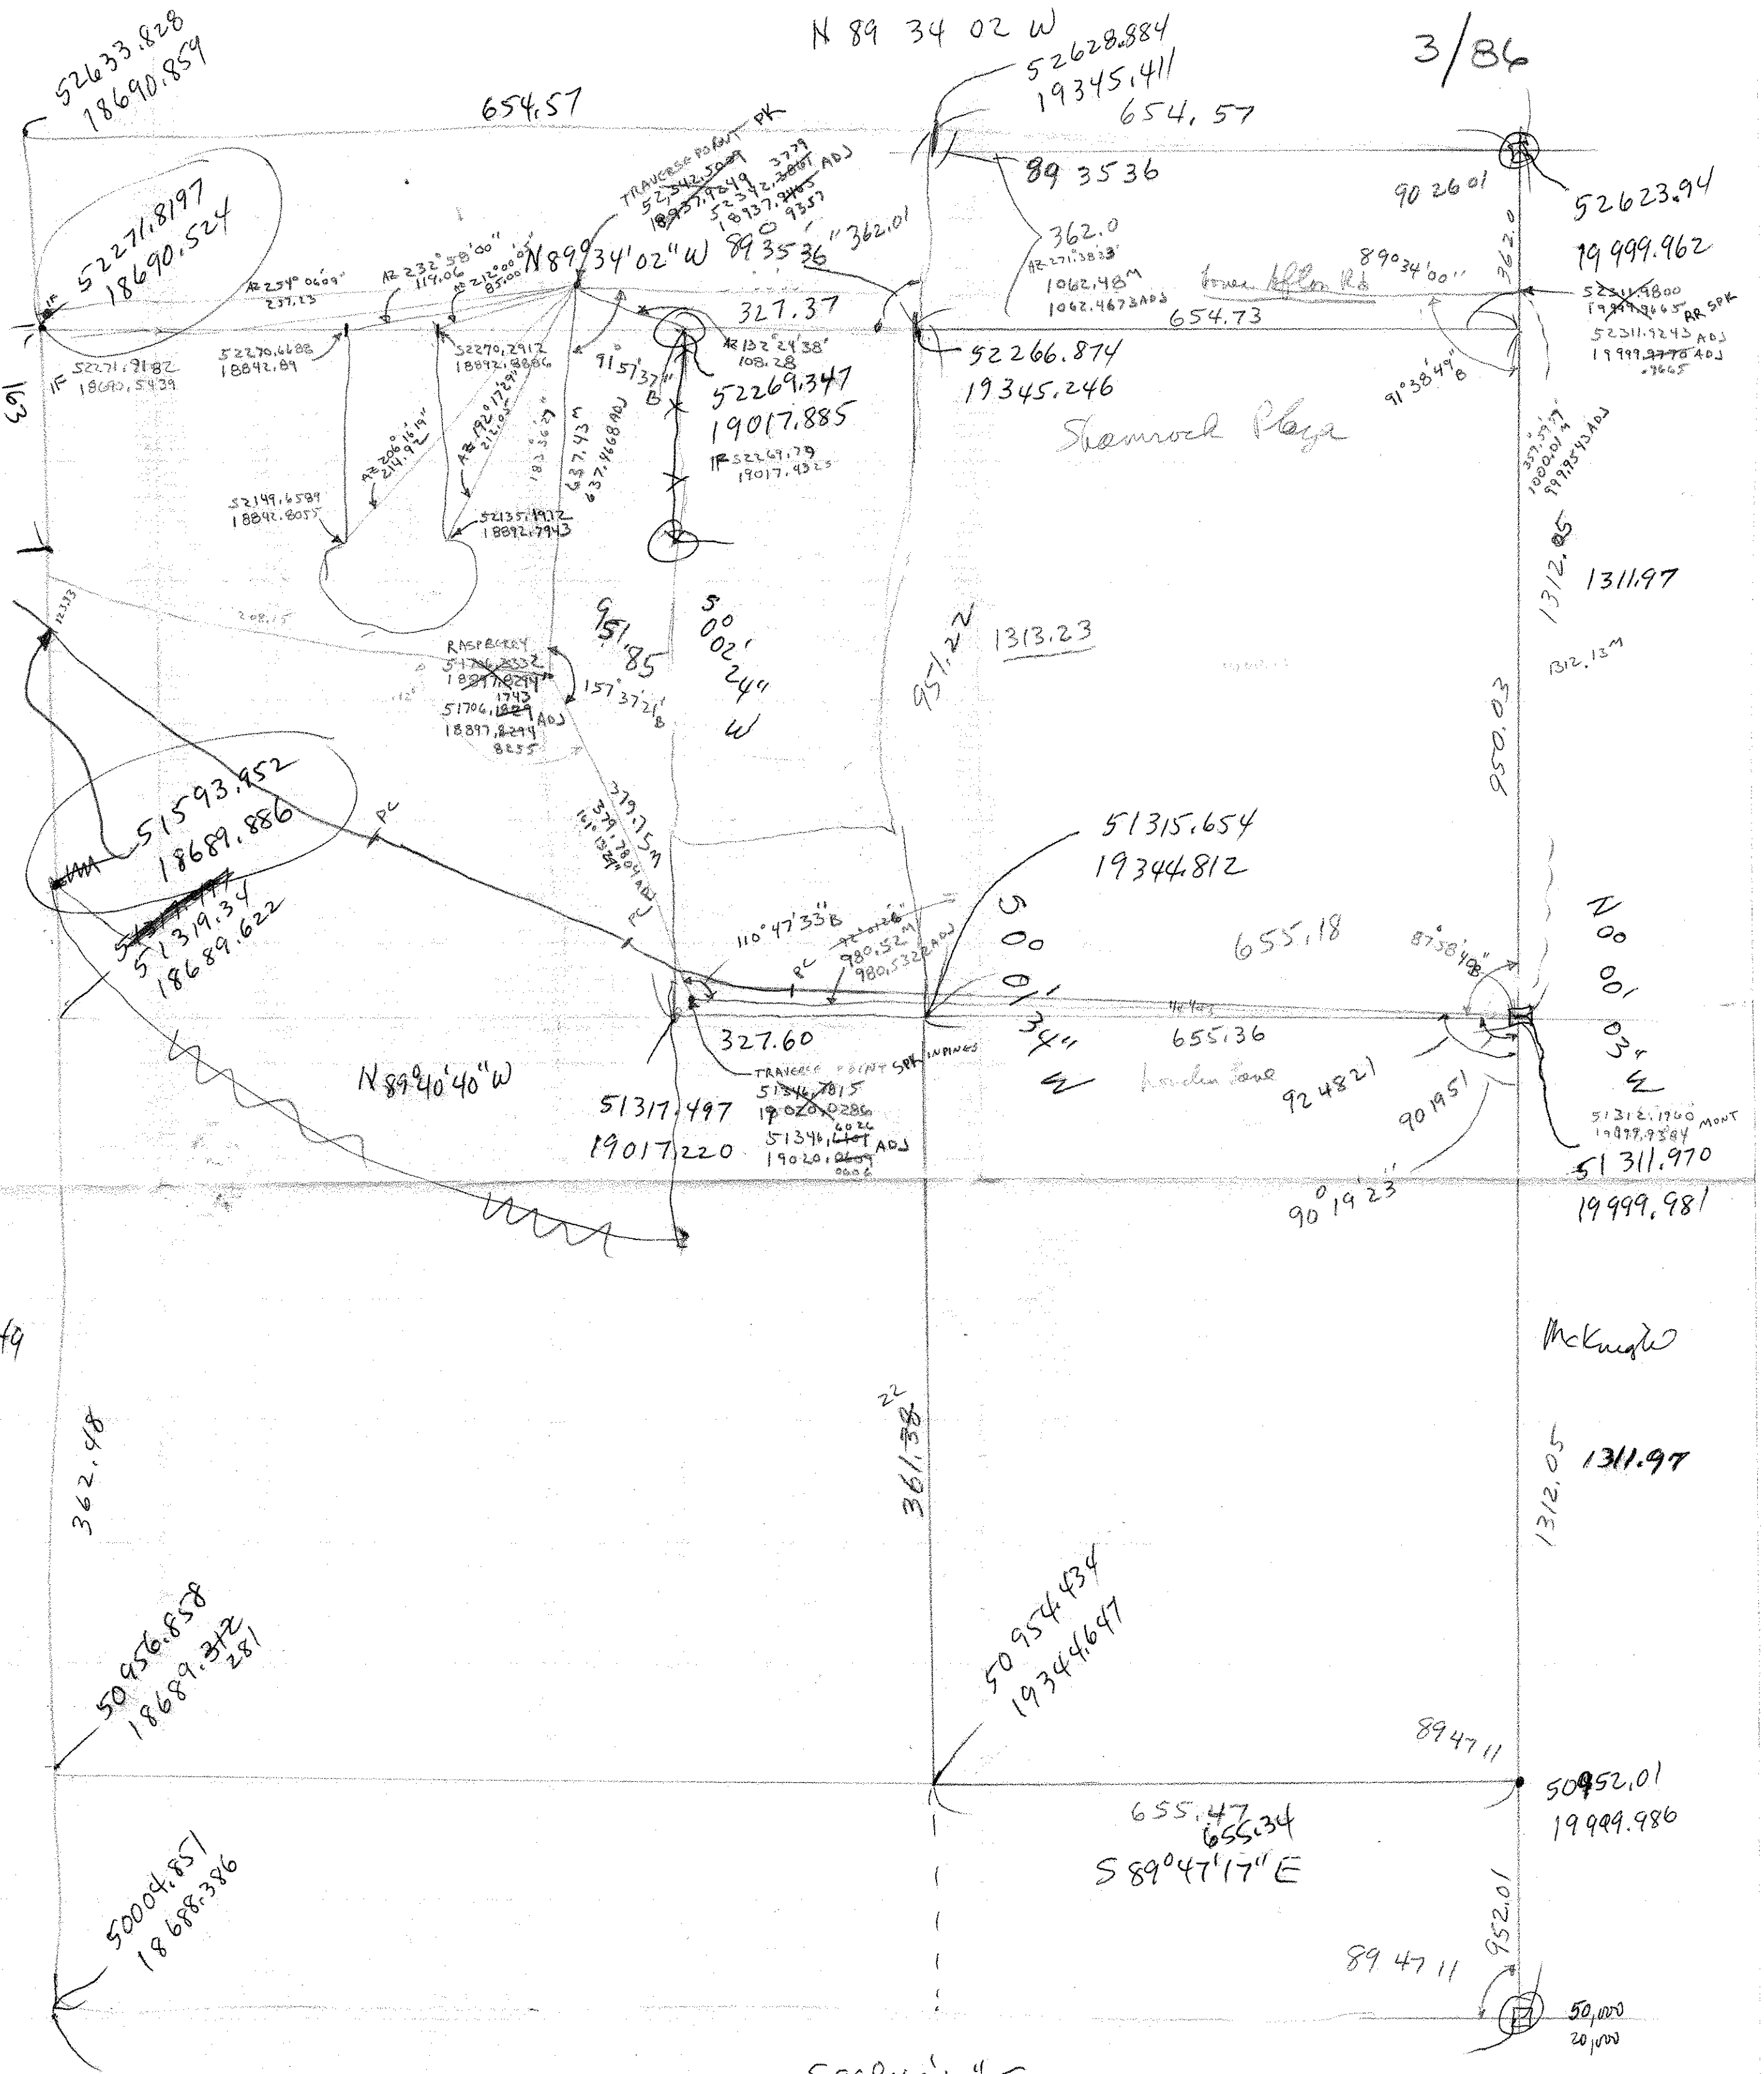


3/86

N 89° 34' 02" W  
52628.884  
19345.411  
654.57

52633.828  
18690.859

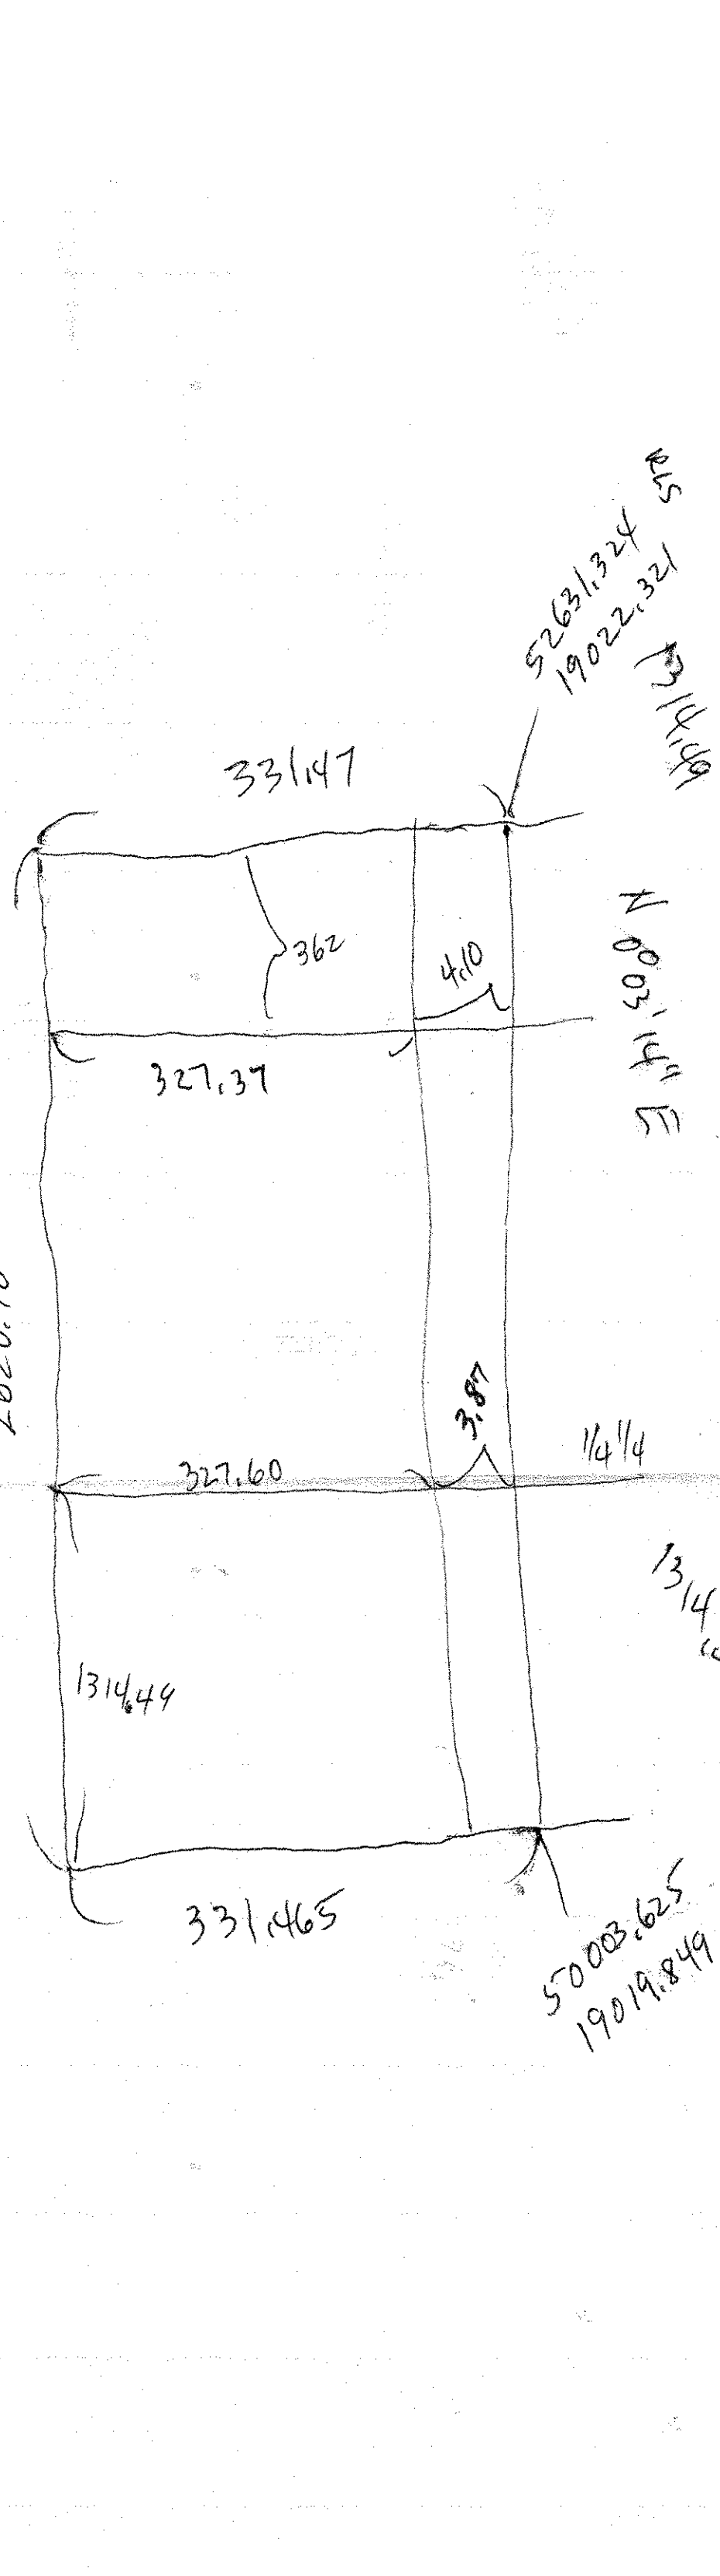

S 89° 47' 17" E