NE 6 28 22

Certificate of Survey

From the office of

GEORGI- SCHMIDT & ASSOC. INC.

3092 No. Lexington Ave., Roseville, Mn. 55113

LAND SURVEYING

483-4408

I hereby certify that this survey, plan or report was prepared by me or under my direct supervision and that I am a duly Registered Land Surveyor under the laws of the State of Minnesota.

Job Number: 2073

Surveyed For Dept. of Planning & Economic Development

Date March 13 1986

Scale 1" = 10'
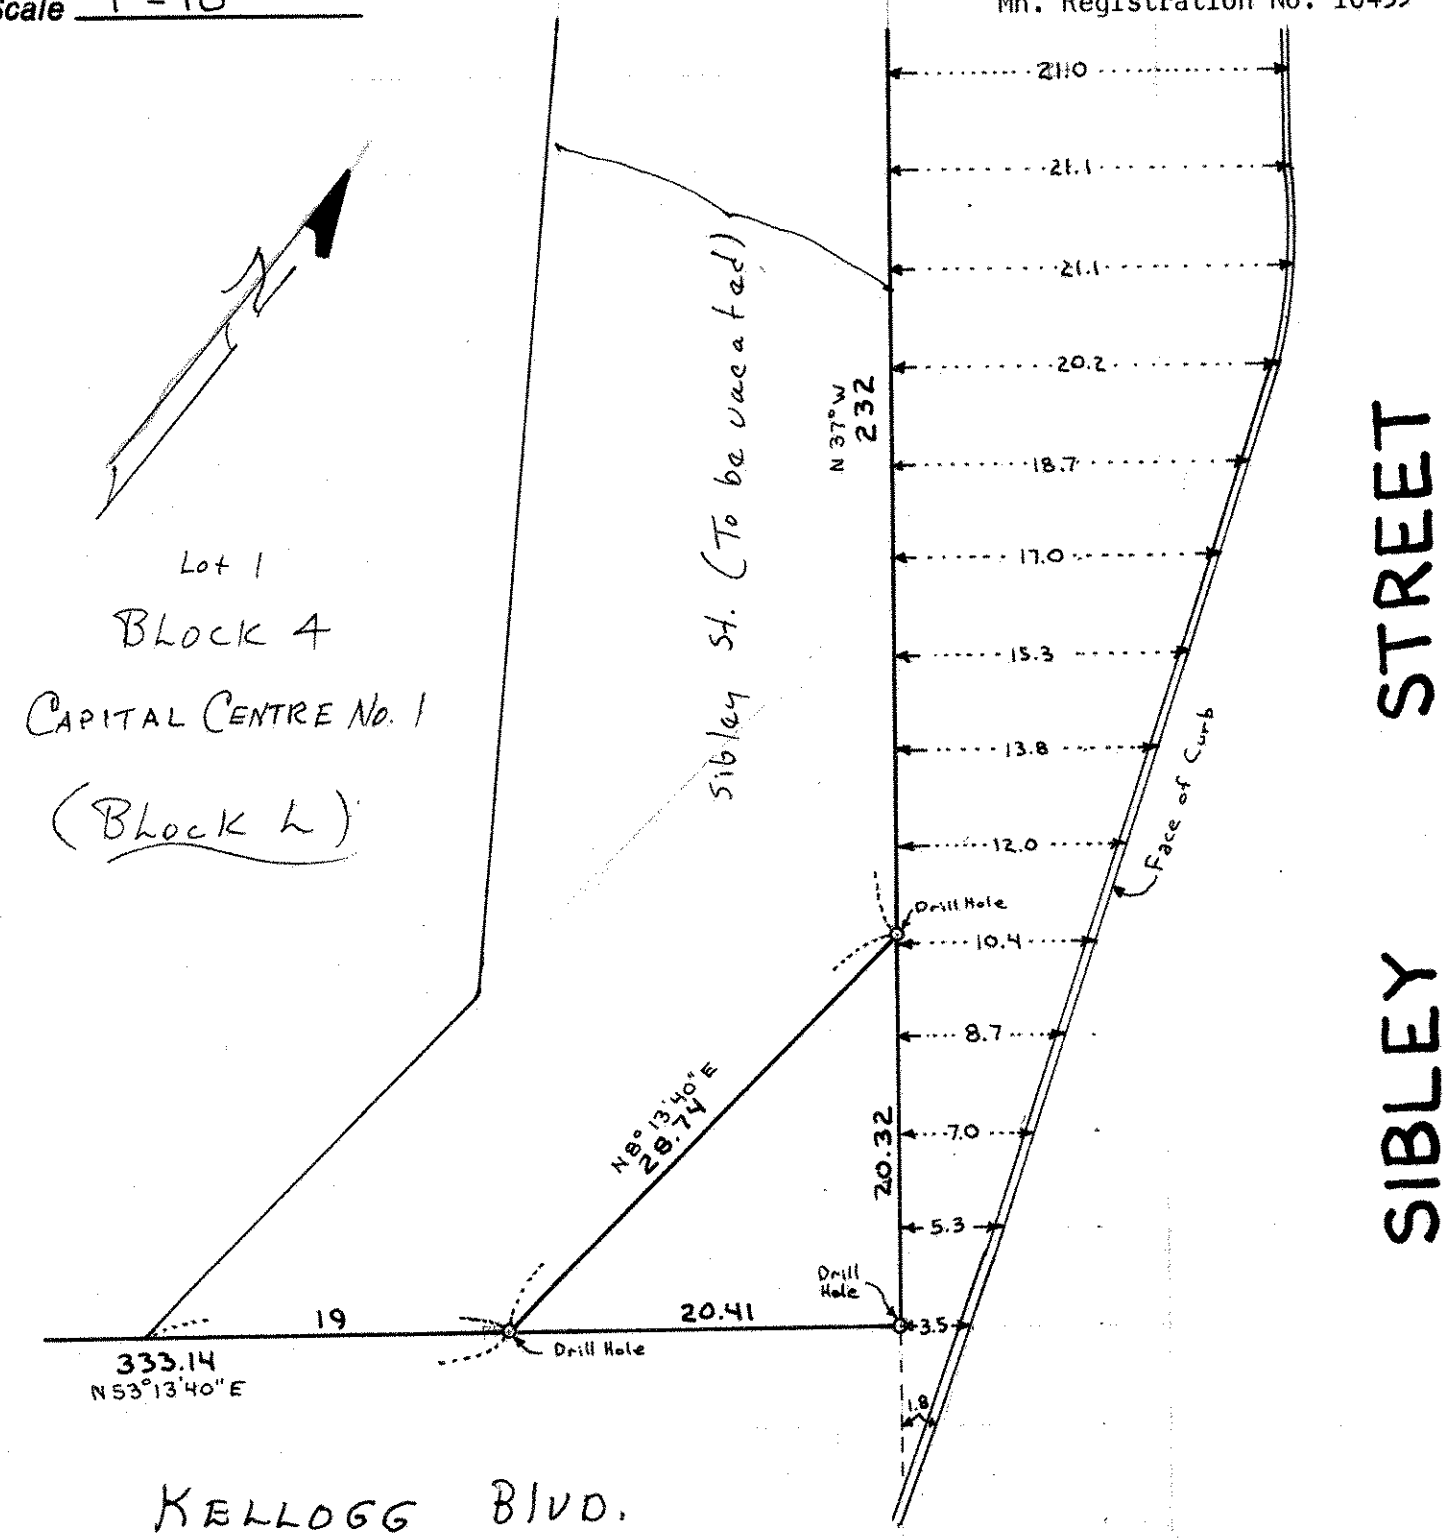
By _____
REGISTERED LAND SURVEYOR
Mn. Registration No. 10459