

NW 15 30 22

Certificate of Survey


From the office of
GEORGI-SCHMIDT & ASSOC. INC.
3092 No. Lexington Ave., Roseville, Mn. 55113
LAND SURVEYING
483-4408

I Hereby Certify that this plat shows a survey made by me of the property described on this plat, and that the corners are correctly placed as shown, that this survey, plan or report was prepared by me, or under my direct supervision; and that I am a duly registered Land Surveyor under the Laws of the State of Minnesota.

Job Number: 3398
Surveyed For Gilbert Hubman
Date 11/11/87
Scale 1" = 40'

By _____
REGISTERED LAND SURVEYOR
Mn. Registration No. 10459

DESCRIPTION:
Lot 1, Block 1, Hubman's High Oaks
Ramsey County, Minnesota

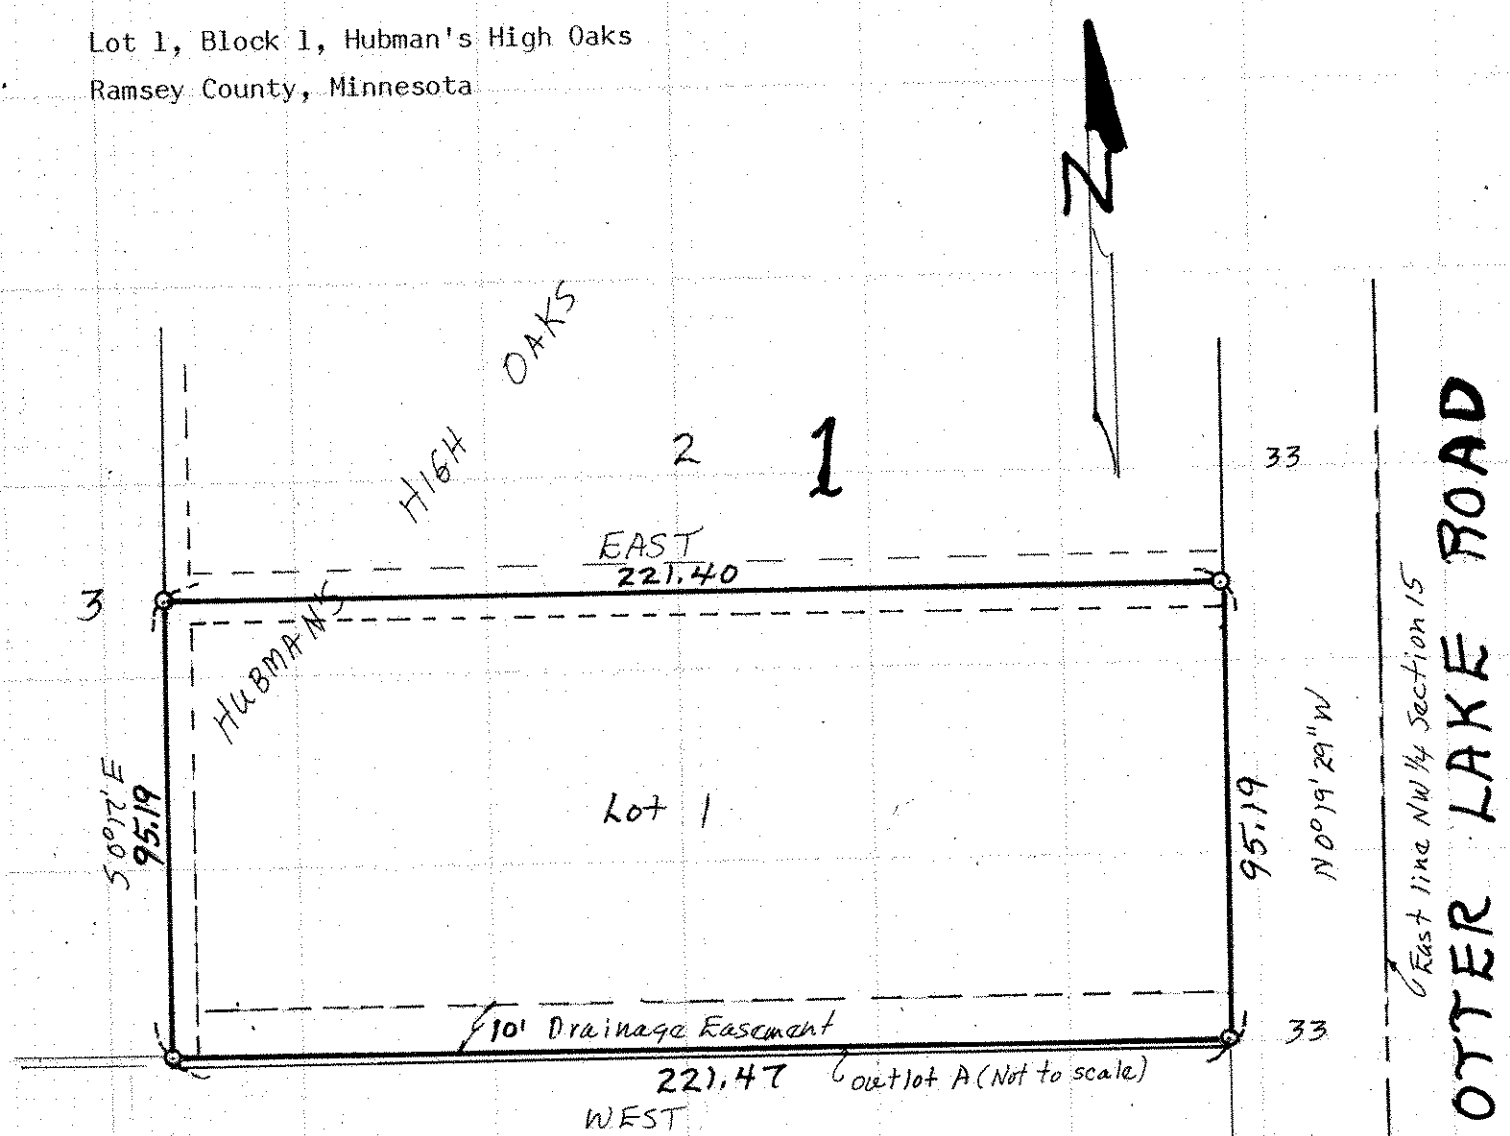

O Denotes Iron Pipe Monument
Easements as per Plat