





I hereby certify that this Certificate of Survey, Description, Easement, Plan or Specification
or Building Location was prepared by me or under my direct supervision and that I am a duly
Registered Land Surveyor under the laws of the State of Minnesota.
David E. Jorgensen Reg. No. 1755 Date 7-11-88

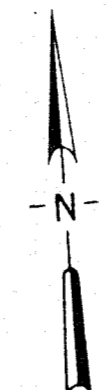

SCALE: 1 inch = 20 feet
o Denotes iron monument

VFW PROPERTY SURVEY

1988

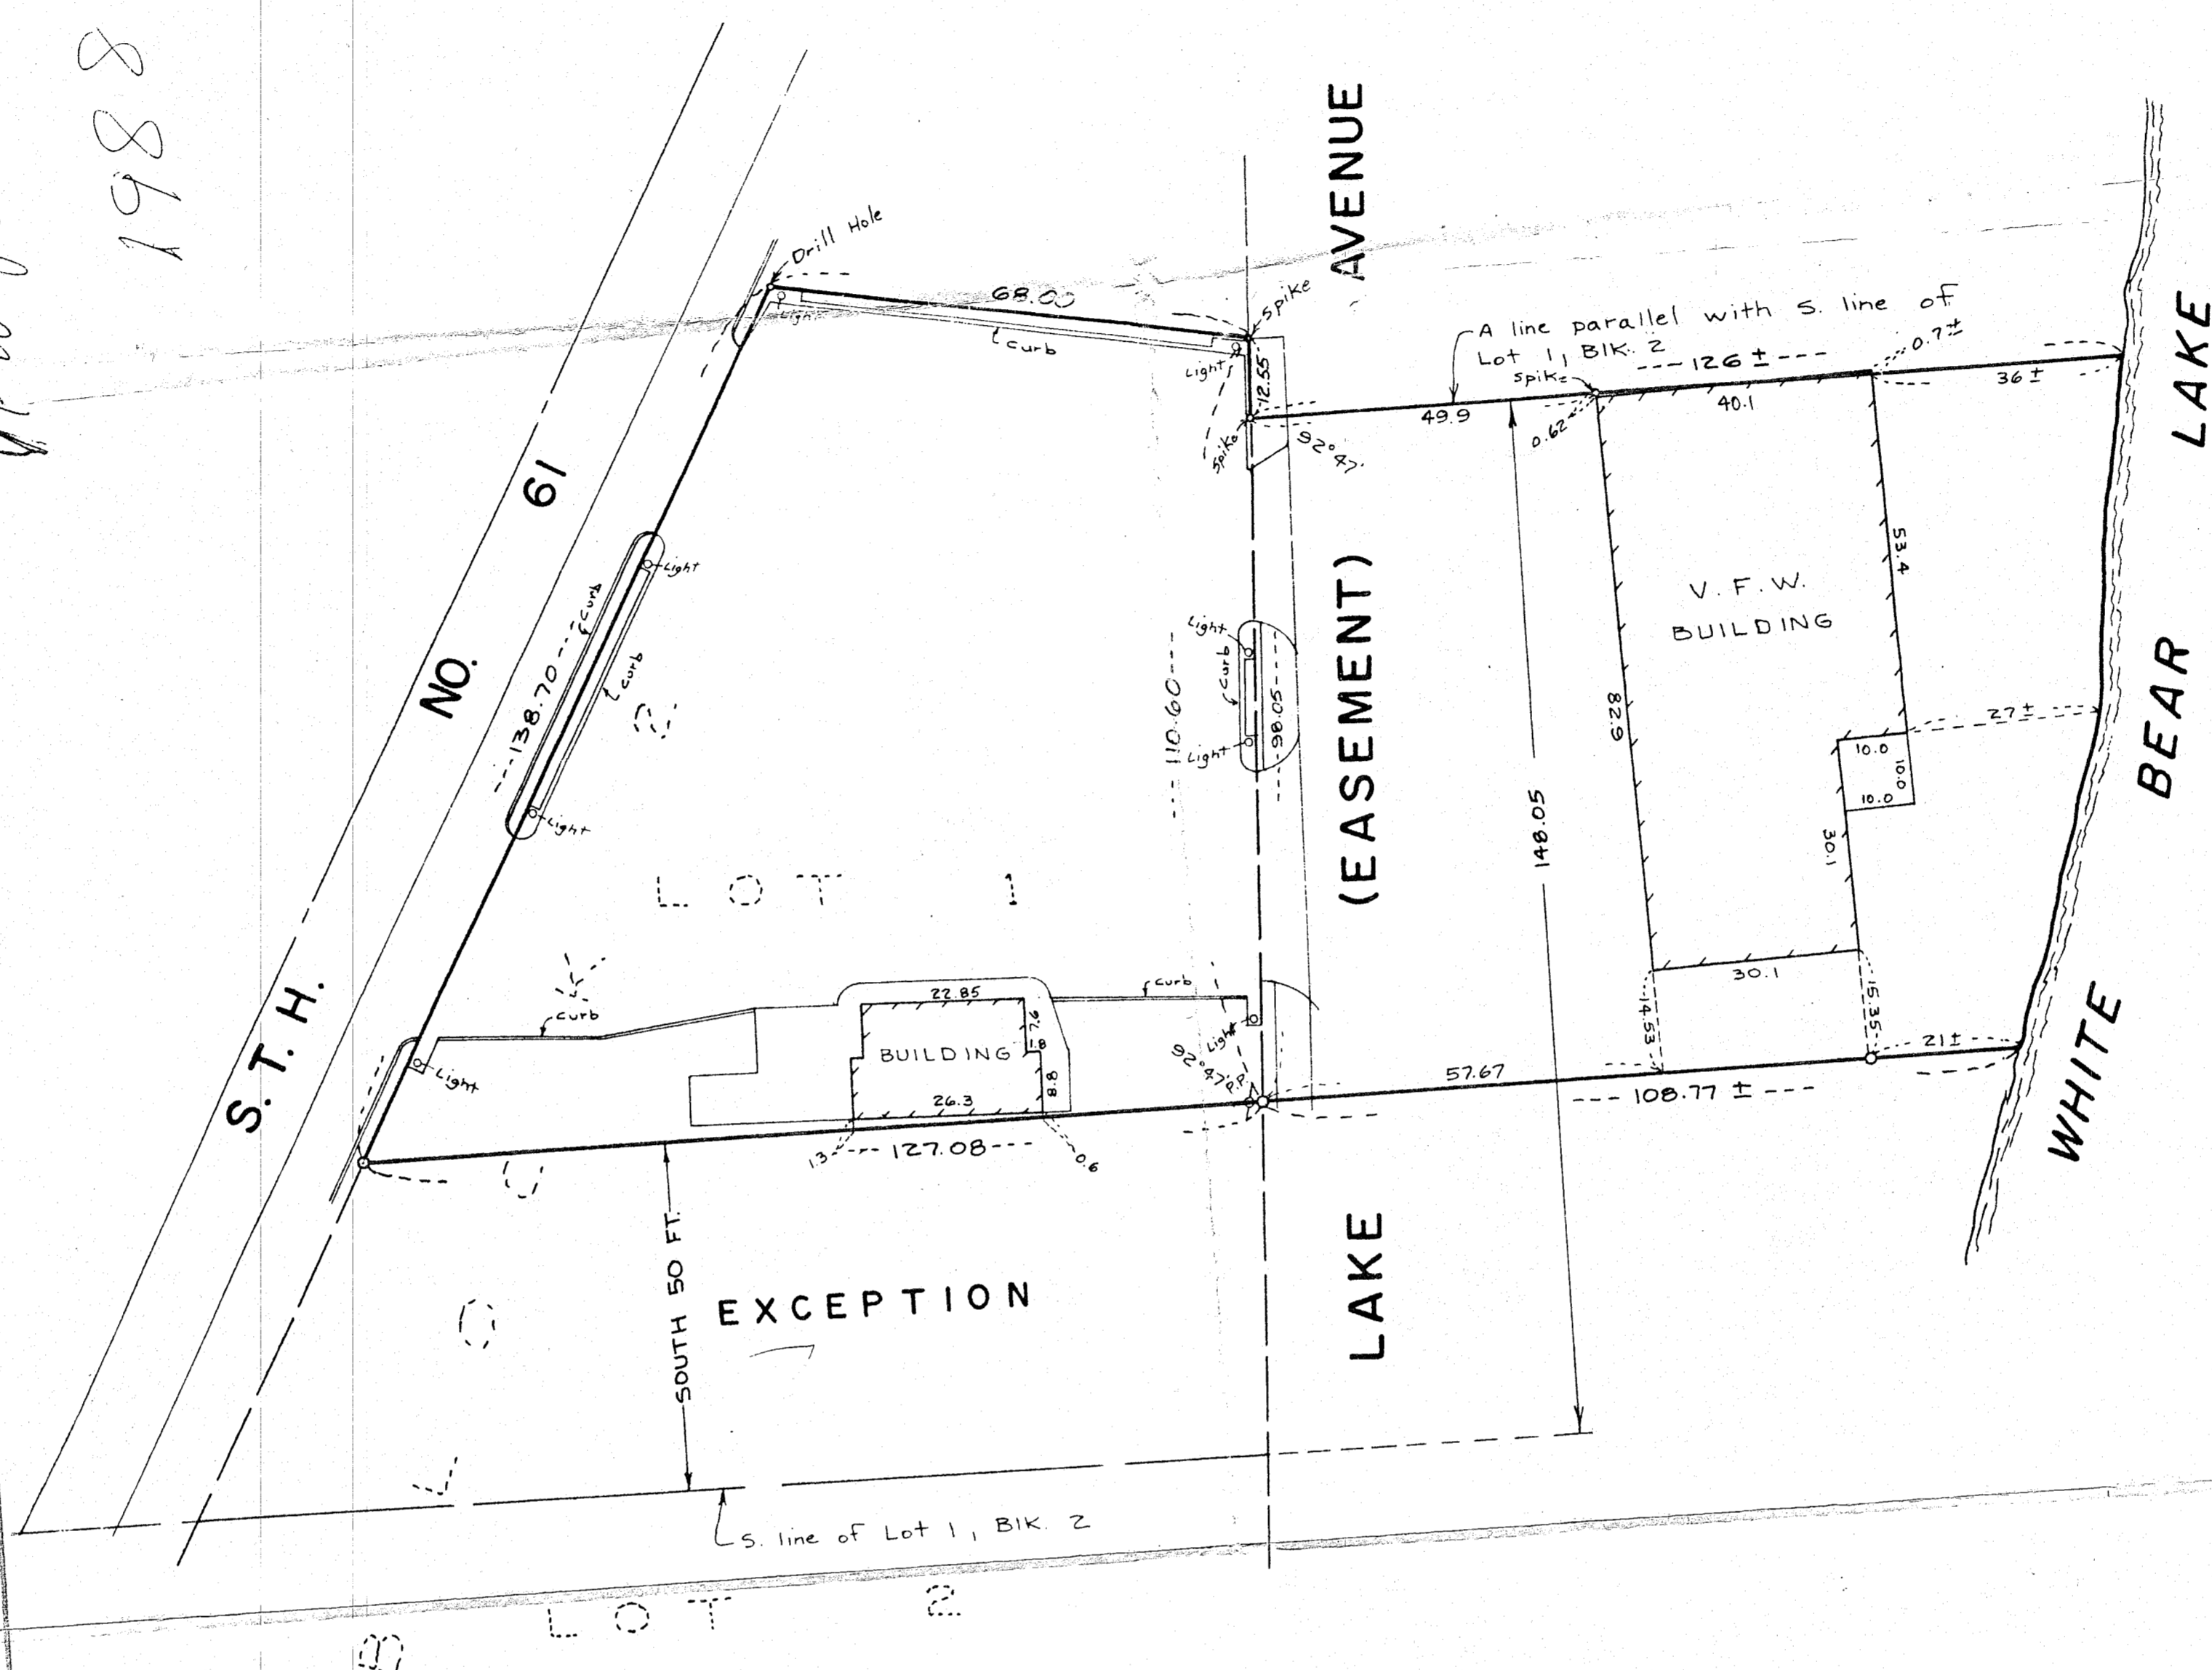

Lot 1, Block 2, Rearrangement of Lake Shore Addition to
White Bear, Minnesota, except the South 50 feet thereof,
subject to rights of public and State of Minnesota in
highways, together with such riparian rights lying North of
the Easterly extension of a line drawn 148.05 feet North
of and parallel to the South line of said Lot 1, Block 2,
appurtenant to said property.

88-155
643-3

1088 REM. FUND
208788 (COPY 2)
+ 1 ORIGINAL COPY