


2616 South Shore

CERTIFICATE of SURVEY

for : JOEL HOLSTAD

SURVEY OF:


LOT 1, BLOCK 1, BELLAIRE
SECOND ADDITION,
RAMSEY COUNTY, MINNESOTA

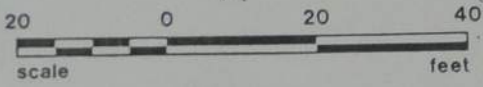

SCALE:
1" = 20' feet

Bearing shown are assumed

- Denotes iron monument marked by Minnesota Registration No. 14945
- Denotes iron monument found

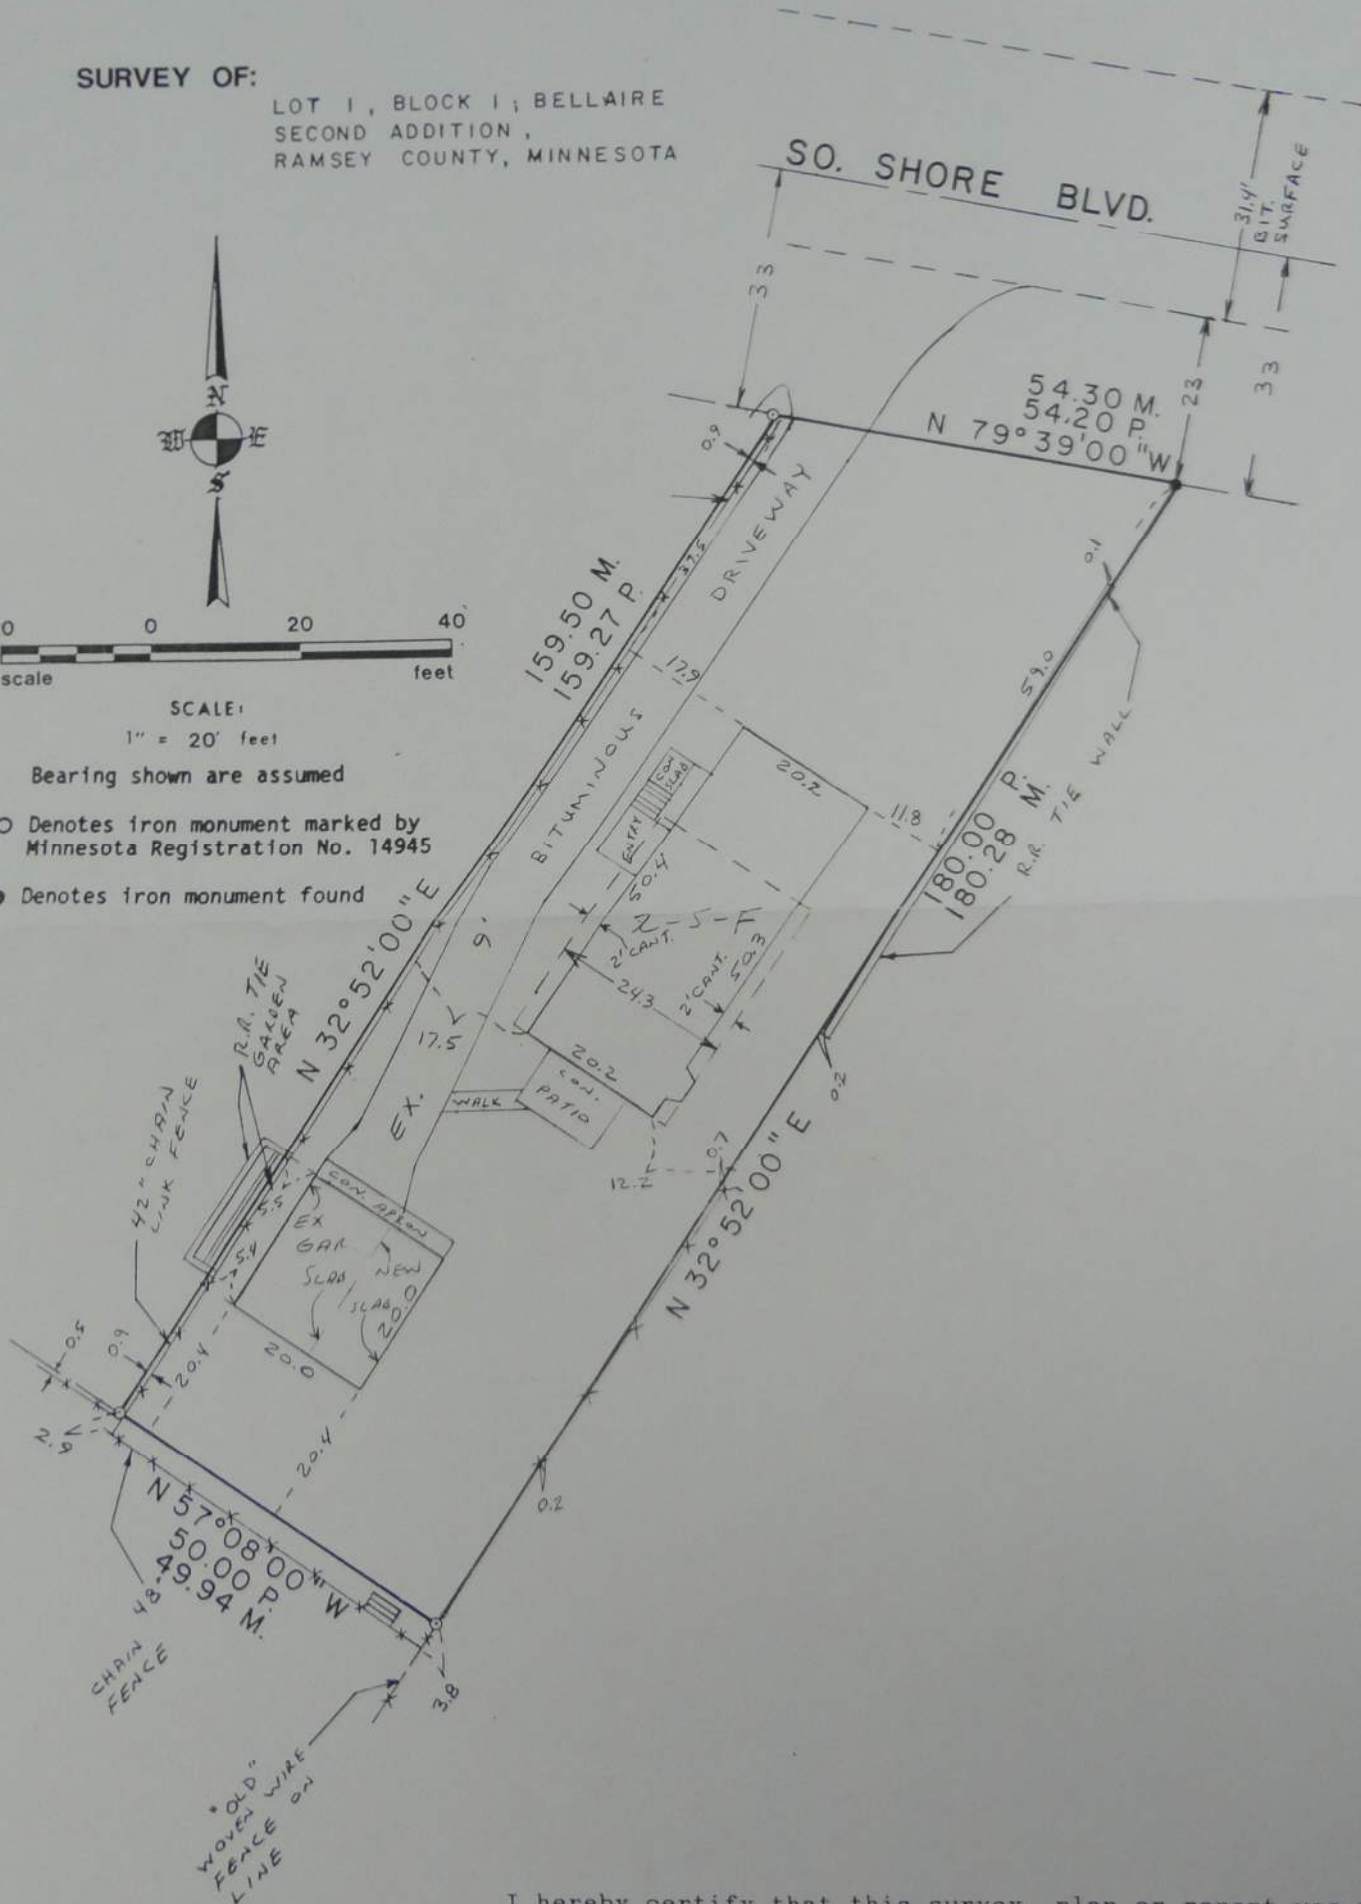

I hereby certify that this survey, plan or report was prepared by me or under my direct supervision and that I am a duly licensed Land Surveyor under the Laws of the State of Minnesota.

Signed this 8th day of August A.D., 1989.

R.E. Stransky Land Surveyors

2301 Woodbridge Street • Suite 201
Roseville, MN 55113
(612) 482-0386

Robert E. Stransky
Robert E. Stransky RLS
Minn. License No. 14945