SW 24 30 22

Certificate of Survey

From the office of

GEORGI- SCHMIDT & ASSOC. INC.

3092 No. Lexington Ave., Roseville, Mn. 55113
LAND SURVEYING
483-4408

I Hereby Certify that this plat shows a survey made by me of the property described on this plat, and that the corners are correctly placed as shown, that this survey, plan or report was prepared by me, or under my direct supervision; and that I am a duly registered Land Surveyor under the Laws of the State of Minnesota.

Job Number: 4007
Surveyed For Leonard Lampert
Date April 24, 1990
Scale 1" = 60'

Description:
The West 130 feet of the East 410 feet of that part of Government Lot 2, in Section 24, Township 30, Range 22, lying North of Schneider Road (now known as South Shore Boulevard) according to the United States Government Survey thereof. Ramsey County, Minn.

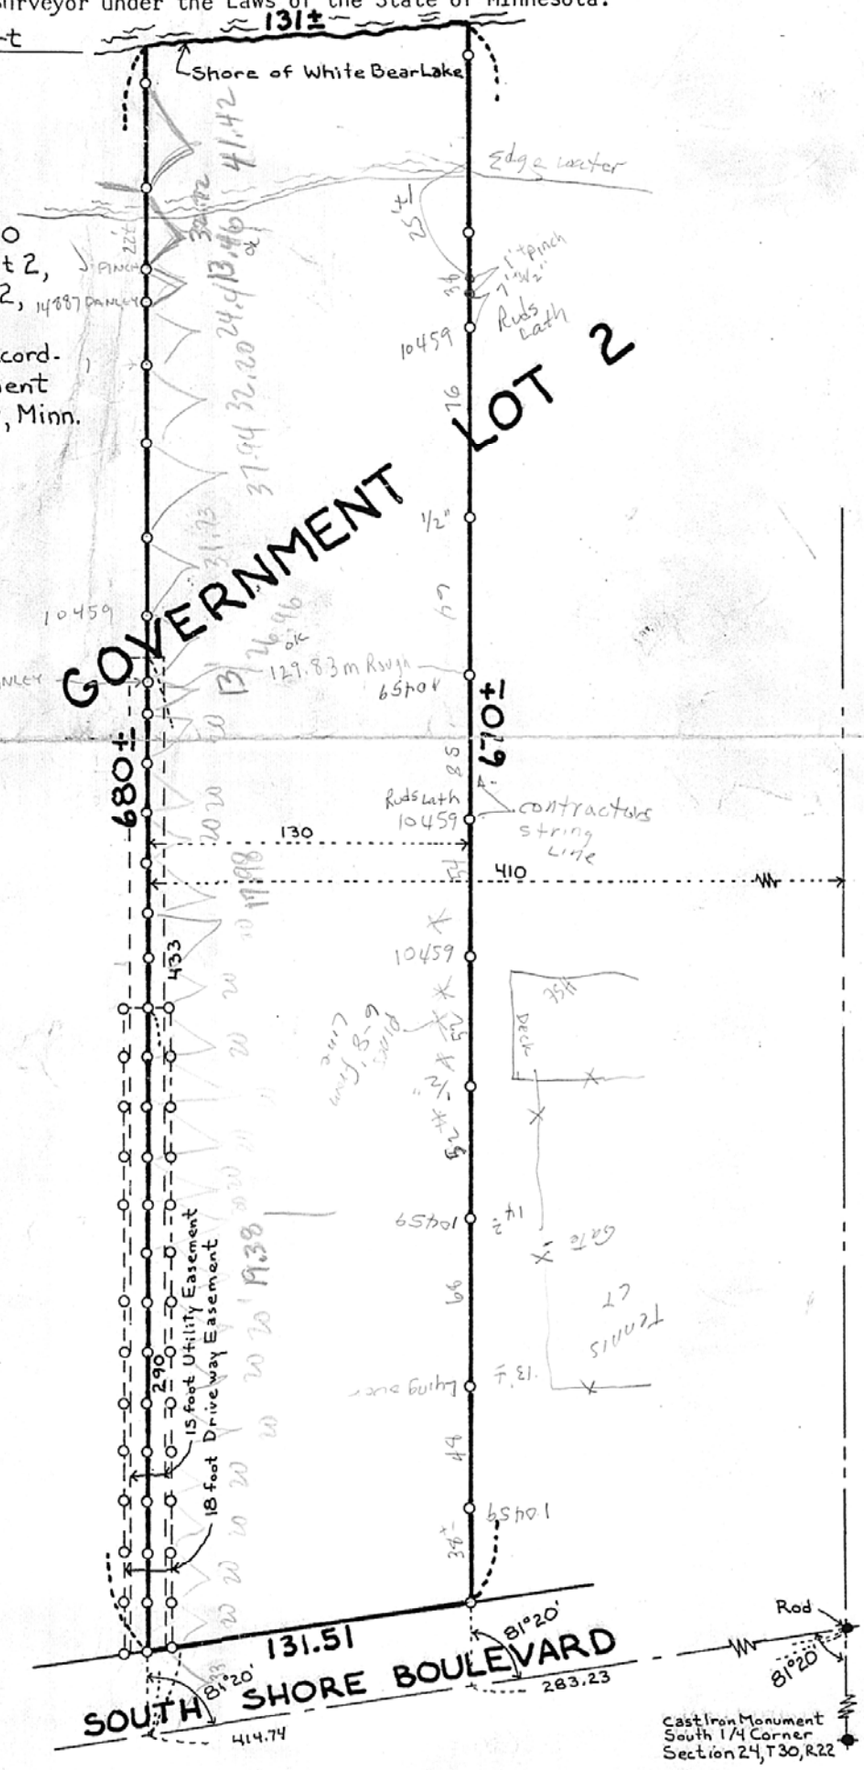

o Denotes Iron Pipe Monument Set

R-93766