

# Certificate of Survey

## From the office of GEORGI-SCHMIDT & ASSOC. INC.

3092 No. Lexington Ave., Roseville, Mn. 55113

LAND SURVEYING

483-4408

I Hereby Certify that this plat shows a survey made by me of the property described on this plat, and that the corners are correctly placed as shown, that this survey, plan or report was prepared by me, or under my direct supervision; and that I am a duly registered Land Surveyor under the Laws of the State of Minnesota.

Job Number: 4073

Surveyed For Robert Bell

Date 8/9/90


Scale 1"=60'

By \_\_\_\_\_  
REGISTERED LAND SURVEYOR  
Mn. Registration No. 10459

DESCRIPTION:

Lot 9, Block 1, Korrol Shores Addition. LAKE OWASSO

Ramsey County, MN

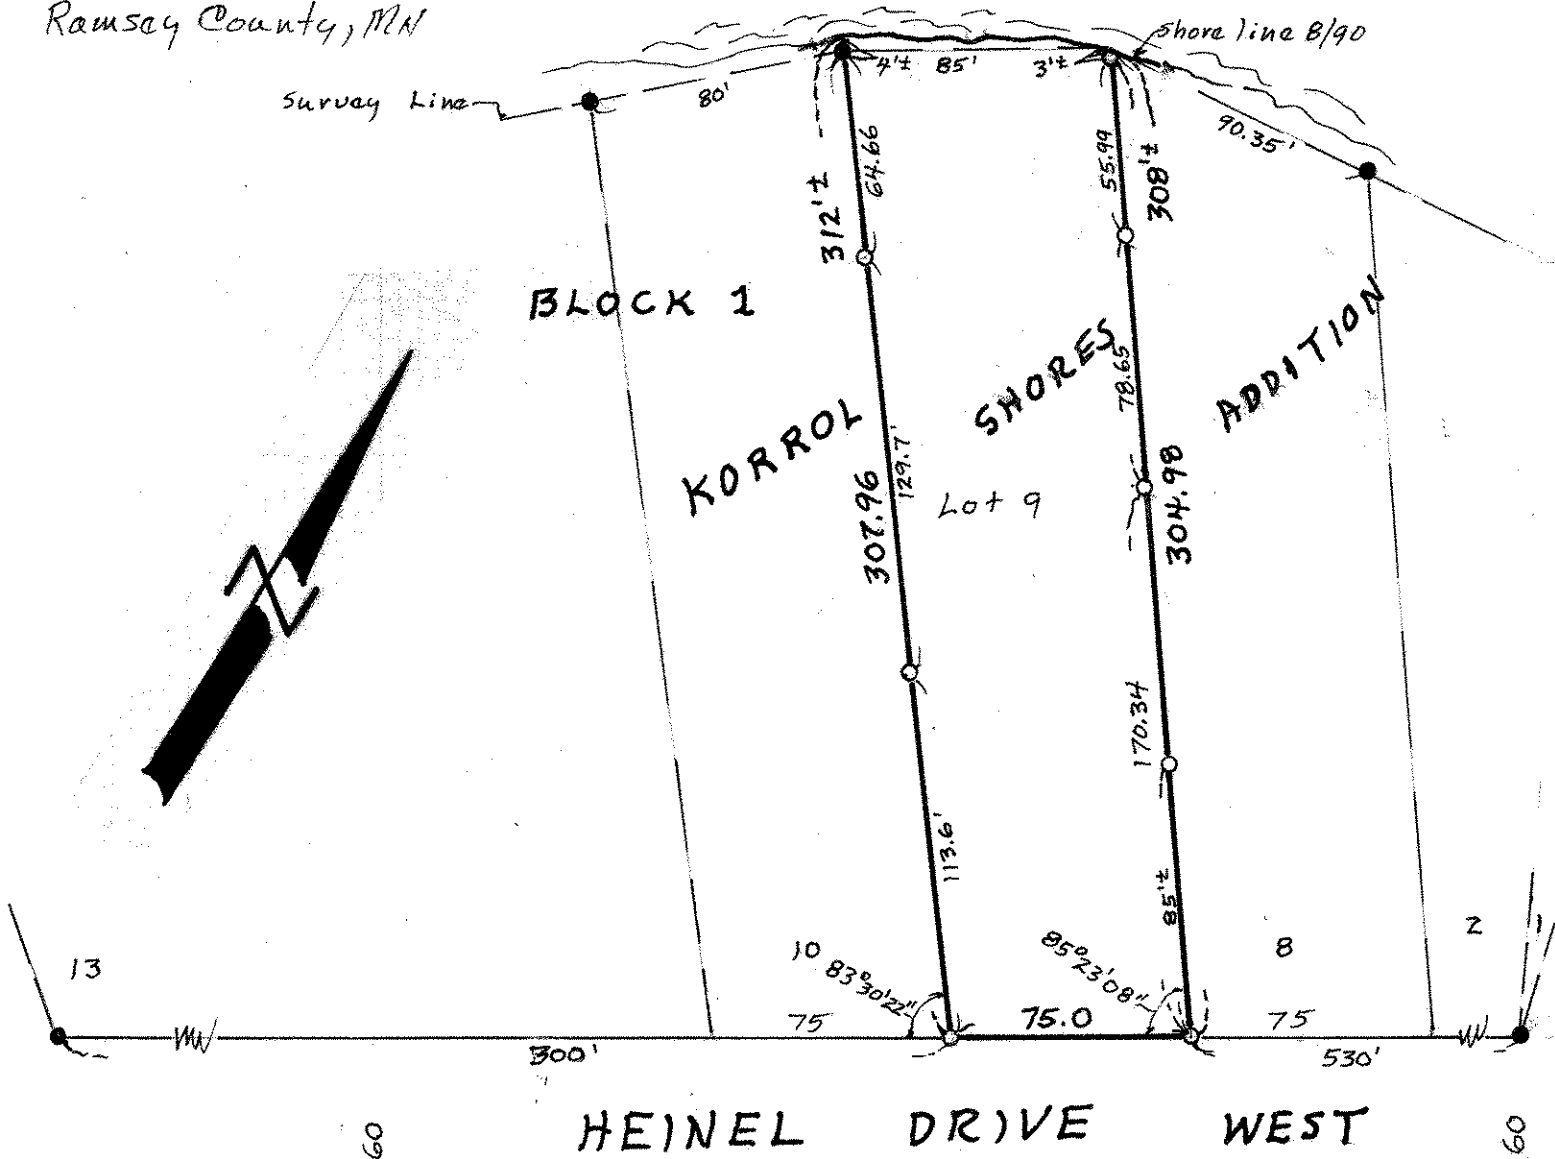

- Denotes Iron found in place
- Denotes Iron Pipe Monument Set