SURFEYED FOR: Andy Boss

DESCRIPTION: (Total)

Lots 13 through 17, Lovell's Rearrangement, Ramsey County, Minnesota.

DESCRIPTION: (Contians 29370 sq.ft., more or less)


Lots 13 through 15, Lovell's Rearrangement, Ramsey County, Minnesota

DESCRIPTION: (Contains 9516 sq.ft., more or less)

Lot 16, Lovell's Rearrangement, Ramsey County, Minnesota

DESCRIPTION: (Contains 9466 sq.ft., more or less)

Lot 17, Lovell's Rearrangement, Ramsey County, Minnesota

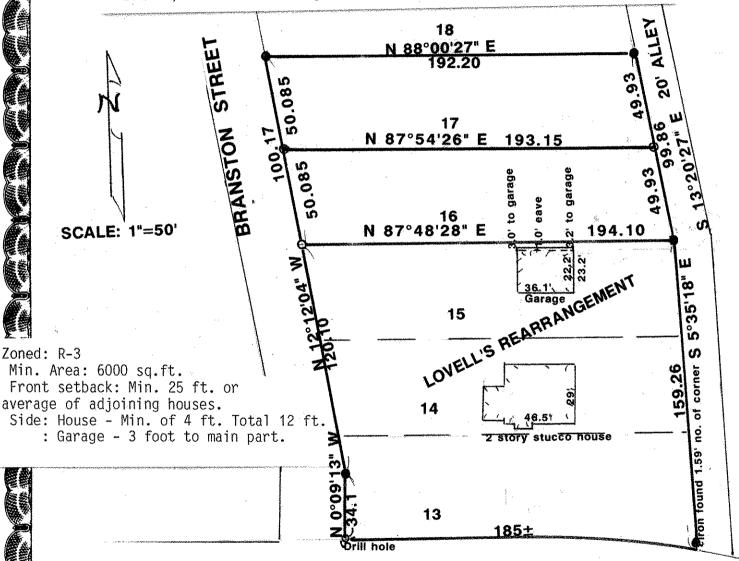

## HENDON AVENUE

- Denotes iron found inplace

o - Denotes iron pipe monument set (unless shown otherwise)

Center line

I hereby certify that this survey, plan plat, preliminary plat or report was prepared by me or under my direct supervision and that I am a duly Registered Land Surveyor under the laws of the State 4/19/92 Addad 100/51/31/92 of Minnesota. R-91841

Job No.

Book No.