

COMSTOCK AND DAVIS INC.


SURVEYED FOR : Robert A. Godfrey

DESCRIPTON: Lot 1, Block 43, Auerbach and Hands Addition to St. Paul, Mn.


Ramsey County, Minnesota

ALBEMARLE

SCALE: 1"=30'

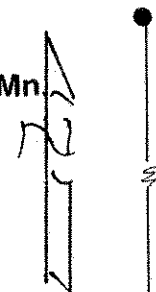

●-Denotes iron found in place
○-Denotes iron pipe monument set

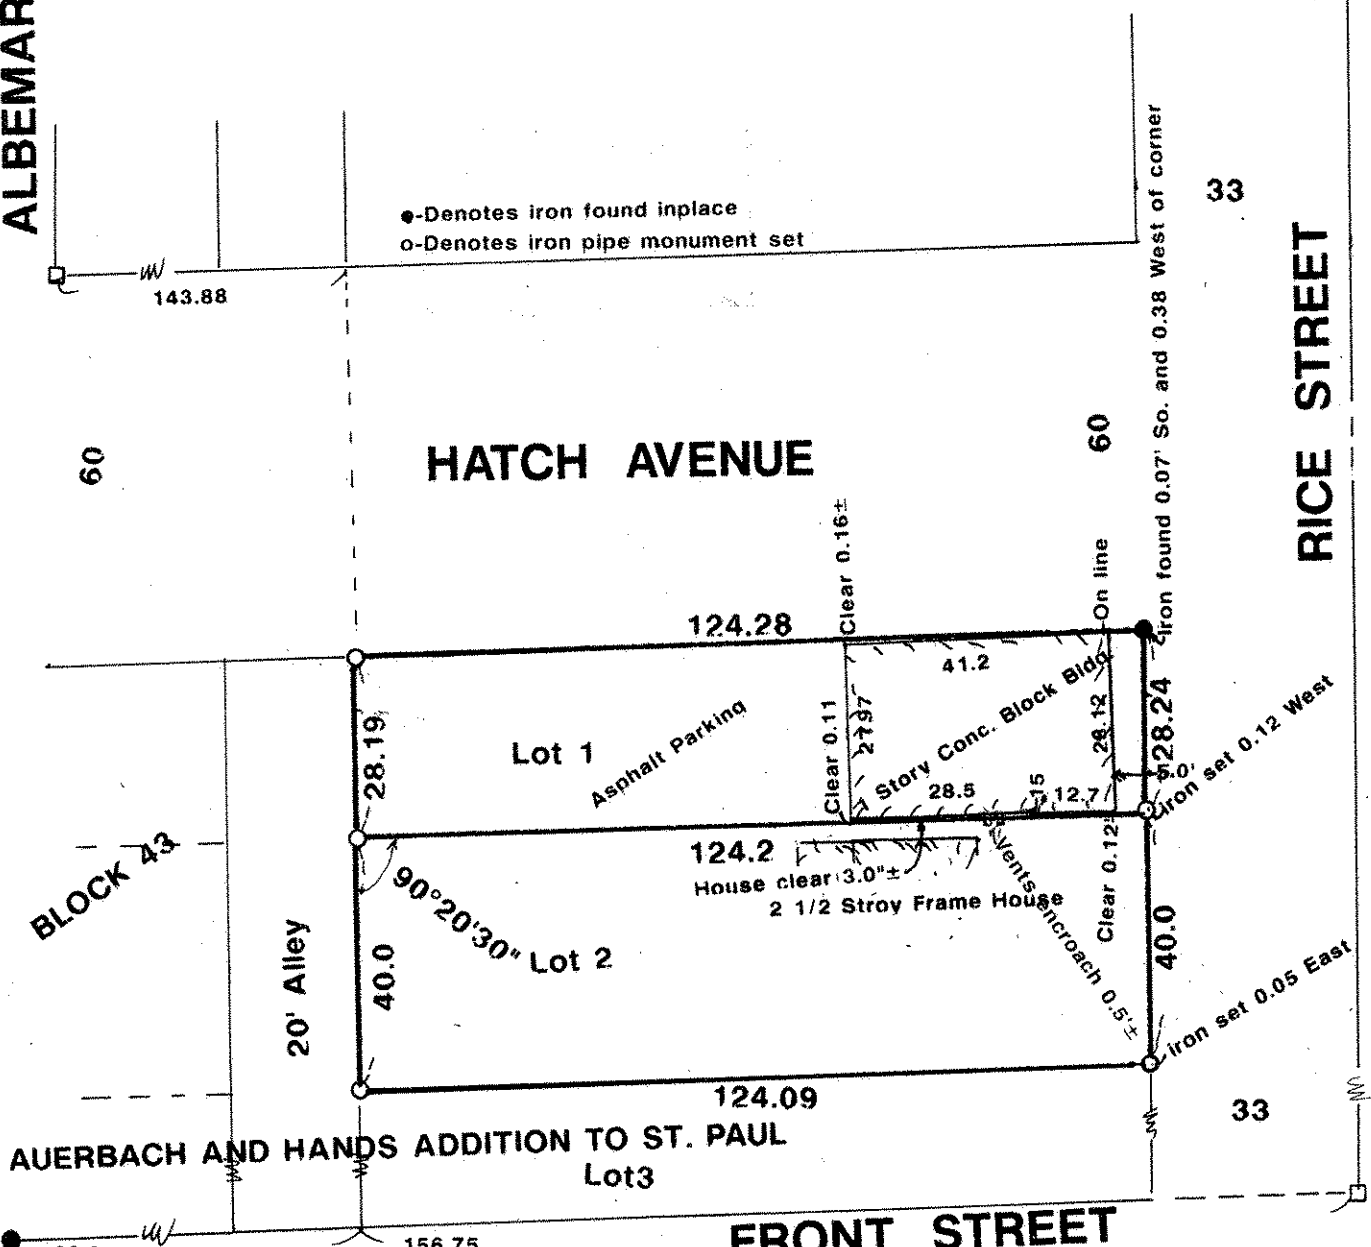

AUERBACH AND HANDS ADDITION TO ST. PAUL
Lot 3

FRONT STREET

I hereby certify that this survey, plan plat, preliminary plat or report was prepared by me or under my direct supervision and that I am a duly Registered Land Surveyor under the laws of the State of Minnesota.

Carole L. Samuel

10459 8/23/91 R-91832
Reg. No. Date Job No. Book No.

East Line of NE 1/4 of Section 25-29-23