


GOMSTOCK AND DAVIS INC.

SURVEYED FOR: Dave Monson as per Elden Morrison

DESCRIPTION:

Lot 3, Block 1, Victor Michels Addition No. 2
 Ramsey County, Minnesota

- Denotes iron pipe monument found in place and verified
- Easements as per Final Plat only

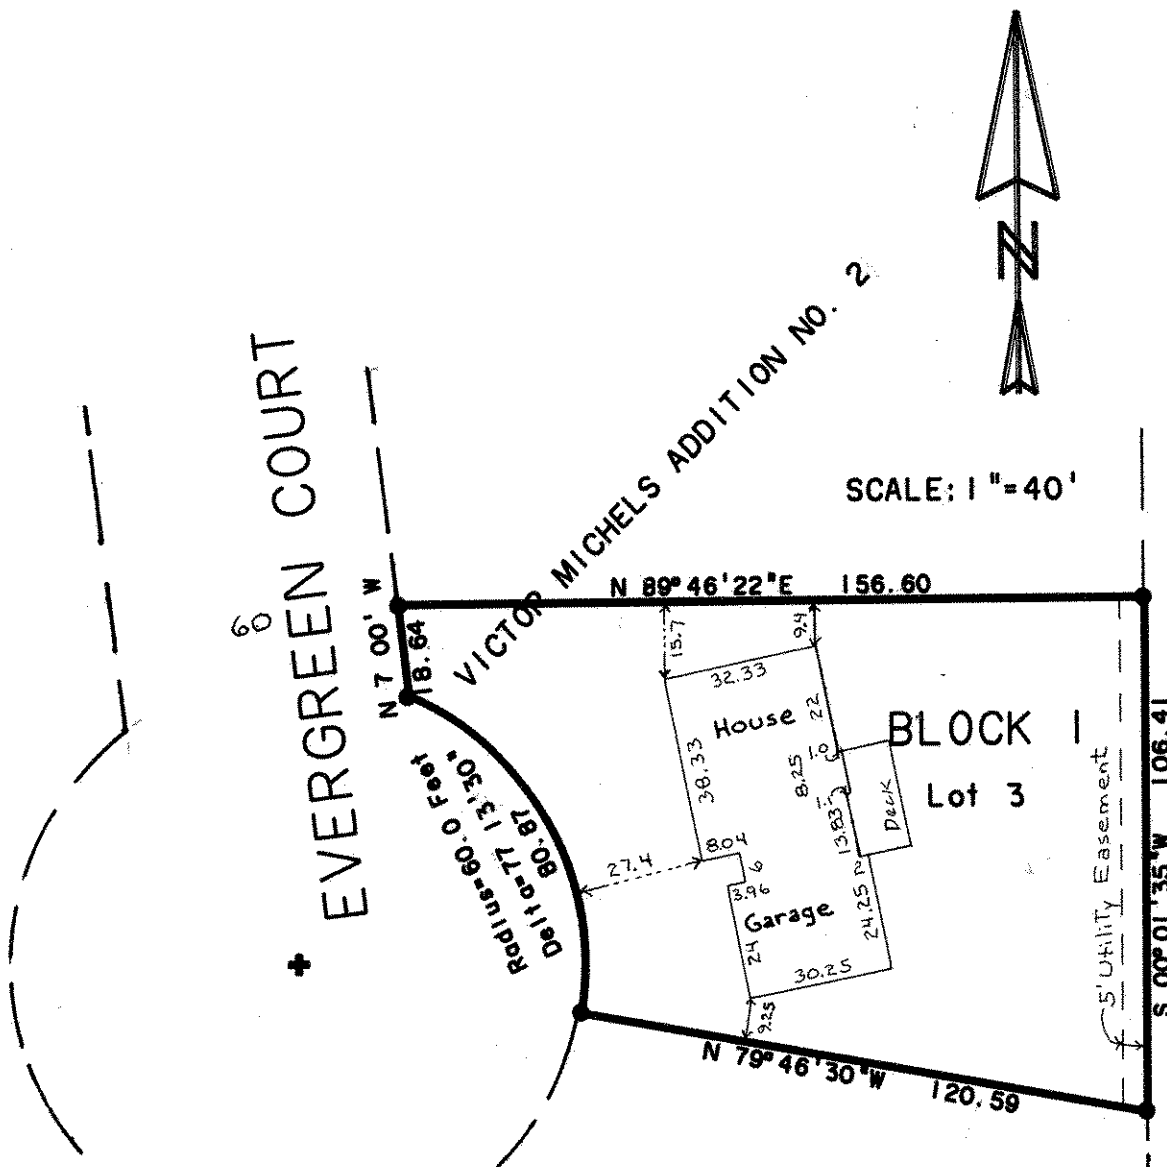

I hereby certify that this survey, plan plat, preliminary plat or report was prepared by me or under my direct supervision and that I am a duly Registered Land Surveyor under the laws of the State of Minnesota.

Juan Carlos Schwartz

10459
 Reg. No.

6/10/91
 Date

R-91800
 Job No.

6/10/91
 Book No.