

DESCRIPTION FROM CERTIFICATE OF TITLE 304001:

All that part of Block 14, Roberts and Randalls Addition to Saint Paul, particularly described as follows: Beginning at a point at the intersection of the southeasterly line of East Ninth Street and the line between Lots 4 and 5 in said Block 14; thence Northeasterly along said southeasterly line of East Ninth Street 227.28 feet to a point; thence Easterly 7.01 feet to the Southwesterly line of Robert Street, as widened; thence Northeasterly along the Southwesterly line of Robert Street, as widened; 

BOUNDARY SURVEY OF PROPOSED MUNICIPAL PARKING FACILITY AT 7TH & ROBERT STREETS



SCALE
1 inch = 20 feet

Point numbers, descriptions, and coordinates of monuments, building corners, intersections of street centerlines that may be used to re-establish this survey or tie in adjacent blocks: (Global Positioning)

396 - Block corner as calculated by extensive survey of this and adjacent blocks is on line with SW face of Northern Furniture Building and 0.10 ft into SE face of building.
N 157808.883 E 574836.064

395 - Block corner. Made 3/4" drill hole in sidewalk 1.00 ft into E. 7th Street sidewalk and 0.32 ft into Robert Street sidewalk. Cemented RLS cap #14946 in drillhole.
N 157986.235 E 575095.546

399 - Block corner. Set iron pipe at back of walks to SE and SW with RLS cap #14946.
N 158194.795 E 574951.933


398 - Block corner. Made 3/4" drill hole in sidewalk and cemented RLS cap #14946 in hole.
N 158196.060 E 574945.031

328 - Centerline-centerline intersection of original Robert St. and 8th Street (New 7th).
N 157966.915 E 575166.522

329 - Centerline-centerline intersection of original Robert St. and 9th Street.
N 158260.110 E 574964.629

331 - Centerline-centerline intersection of original 8th Street (New 7th) and Minnesota Street.
N 157745.928 E 574843.197

S'ly corner of old Northern Furniture Building is 0.21 ft into Minnesota Street R/W according to P.J. Armstrong survey of Oct. 29, 1954; but extensive survey of this and adjacent blocks indicates the SW building face here is on Minnesota St. R/W.

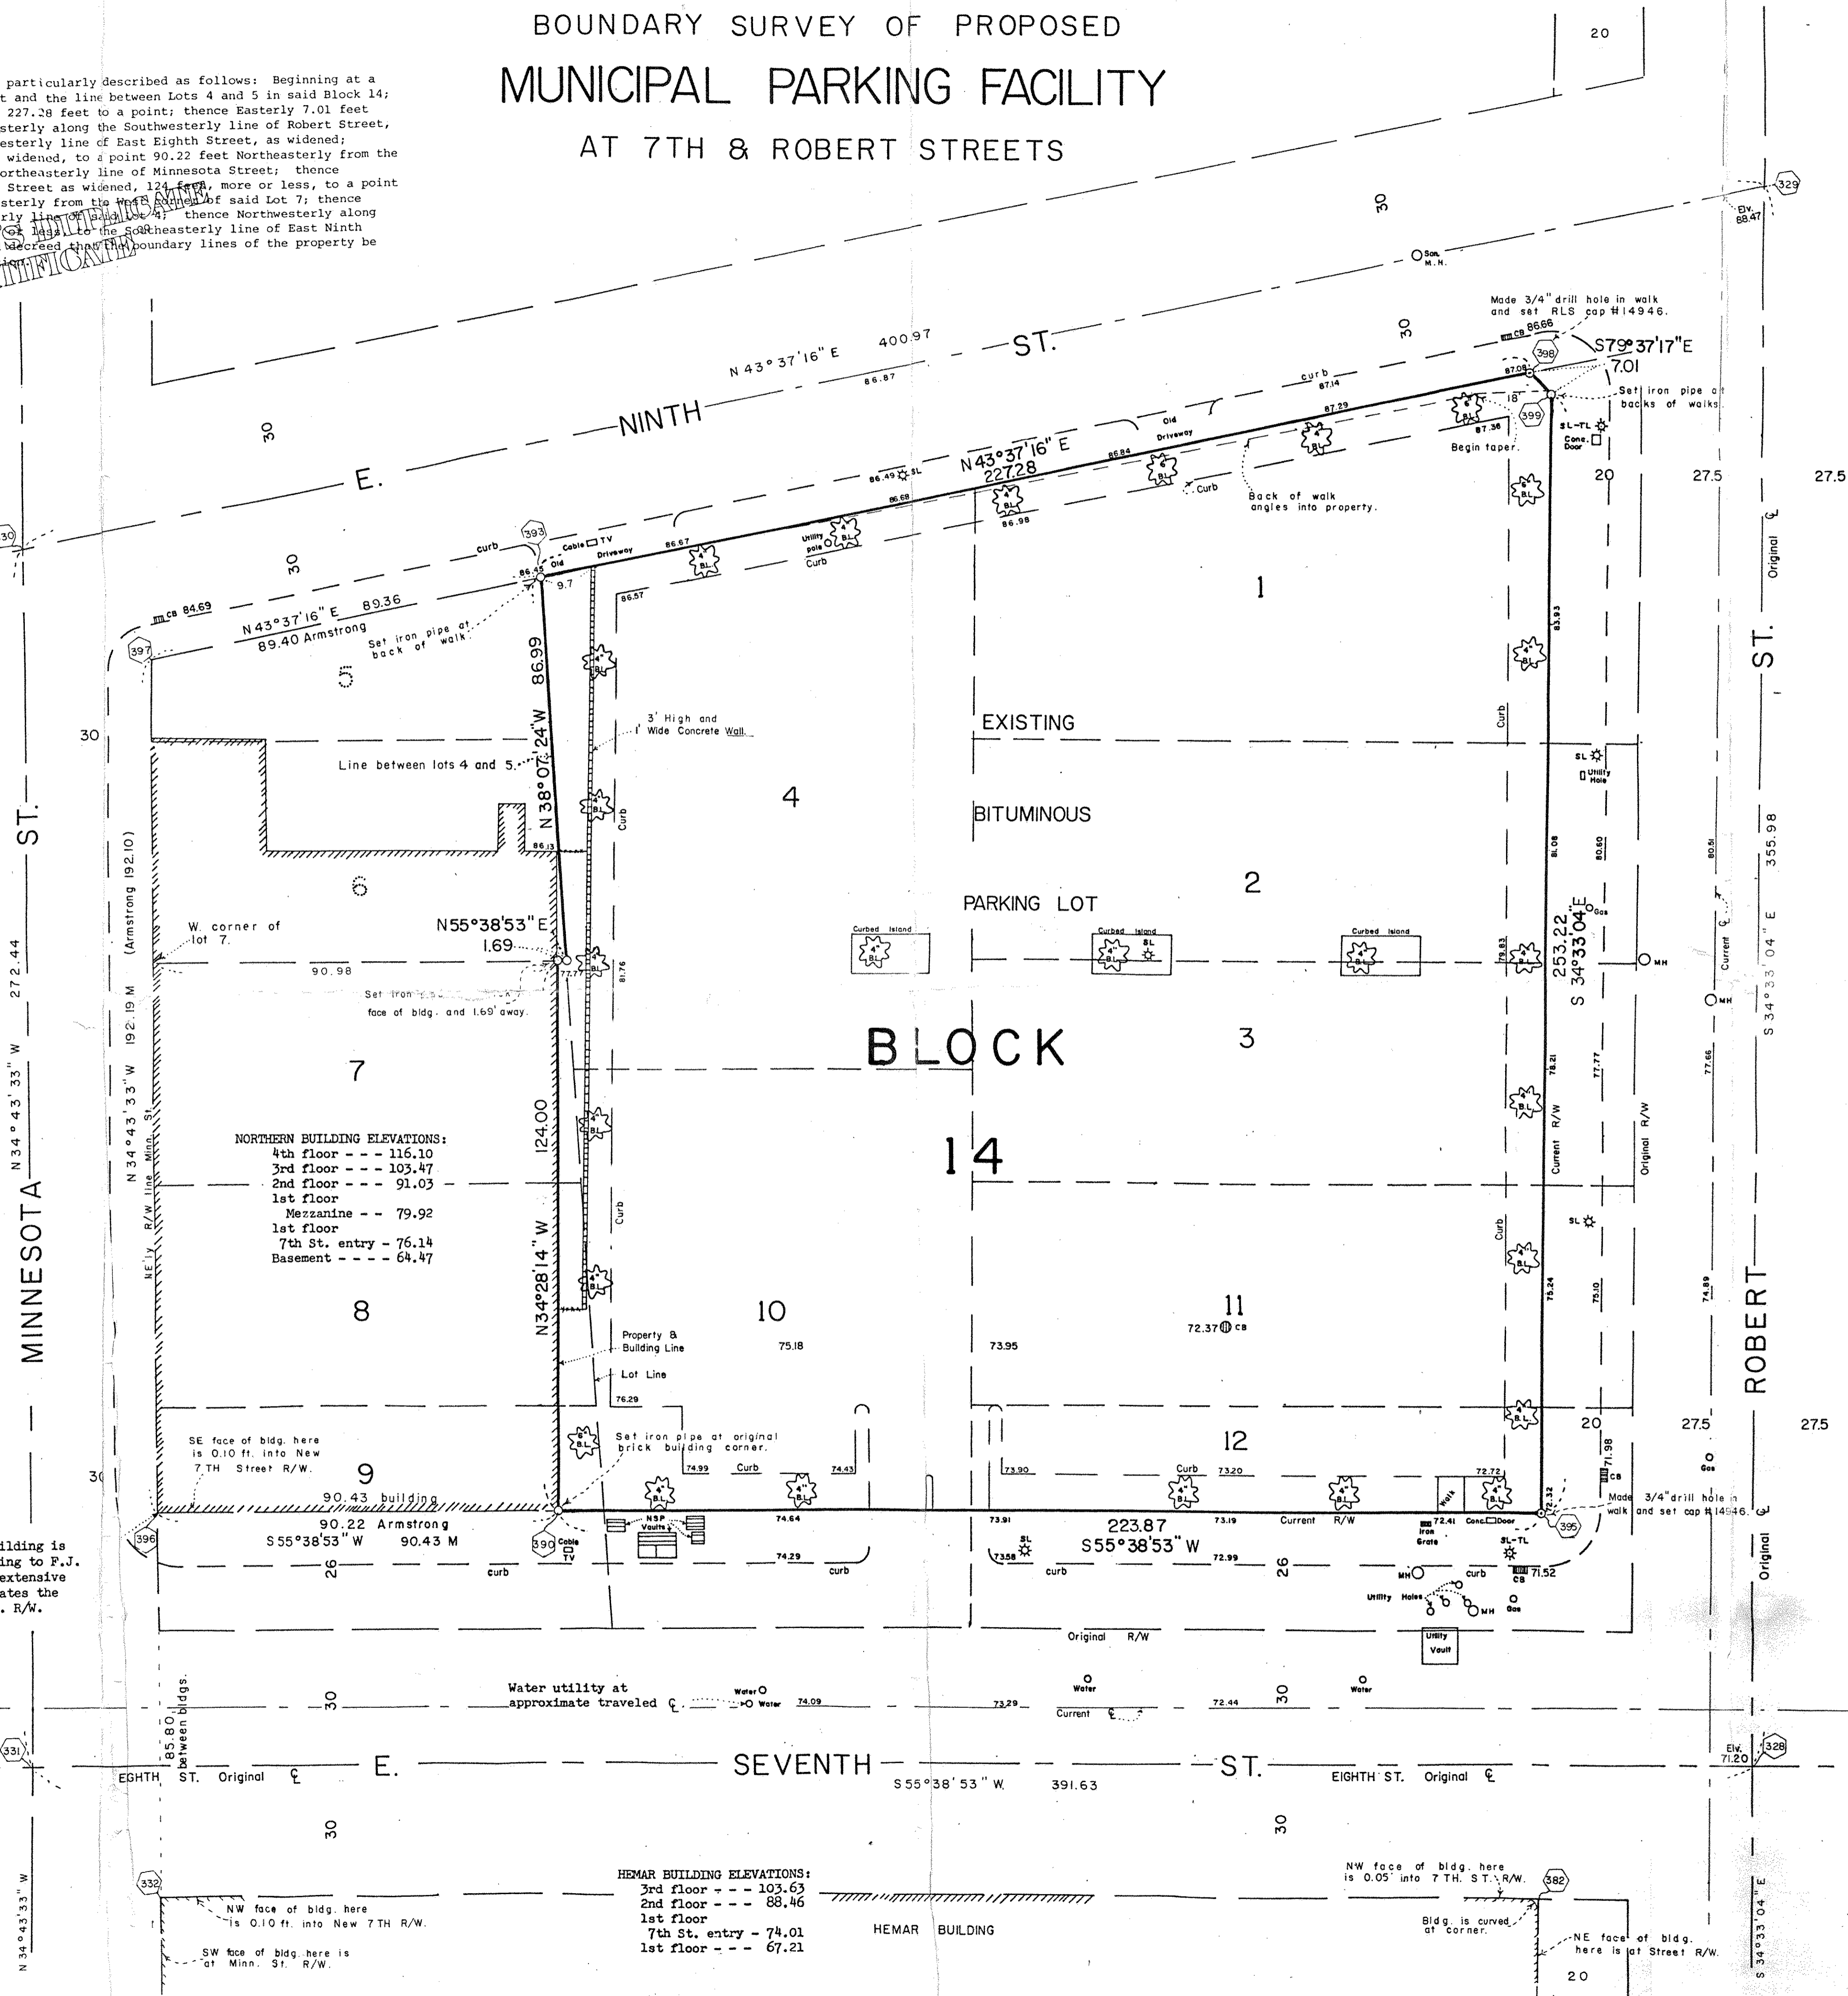

NORTHERN BUILDING ELEVATIONS:

4th floor	116.10
3rd floor	103.47
2nd floor	91.03
1st floor	79.92
Mezzanine	79.92
1st floor	76.14
7th St. entry	76.14
Basement	64.47

HEMAR BUILDING ELEVATIONS:

3rd floor	103.63
2nd floor	88.46
1st floor	74.01
7th St. entry	74.01
1st floor	67.21

NOTES:

Elevations are above City of St. Paul Datum. Add 694.10 feet for Mean Sea Level Elevations, 1929 NAVD.

75.21 = spot elevations (example).

B.L. indicates Broad Leaf Tree.

SL indicates street light.

SL-TL indicates street light and traffic light.

CB indicates Catch Basin.

--- indicates chain link fence.

HORIZONTAL CONTROL was based on Global Positioning Systems (GPS) monuments.

○ = iron pipe set with RLS cap #14946.

⊙ = arill hole made in sidewalk.

M indicates measured values where there is disagreement with record values.

⊙ indicates block or property corner number (example), or intersection of street centerlines.

This revision of 3-27-92 shows bearings and coordinates based on Global Positioning Systems monuments. Distances along property lines were only slightly adjusted.

I hereby certify that this survey, plan, or report was prepared by me or under my direct supervision and that I am a duly Registered Land Surveyor under the laws of the State of Minnesota.

Carl Leach
Date 11-27-91 Reg. No. 14946

REVISED 3/27/92

NORTH LAND SURVEYING COMPANY
MINNESOTA