

GOMSTOCK AND DAVIS INC.

Surveyed for Sue Schnarr


Description:

Lot 5 and that part of Lot 6 lying Southeasterly of a line described as beginning at a point on the North line of said Lot 5 distant 10.0 feet (arc measurement) West of the Northeast corner of said Lot 6, said line terminating at the Southeast corner of said Lot 6, all in Block 3, Lewiston Heights.

SCALE: 1" = 50'

- Denotes Iron Pipe Found
- o Denotes Iron Pipe Set

Ramsey County, Minnesota

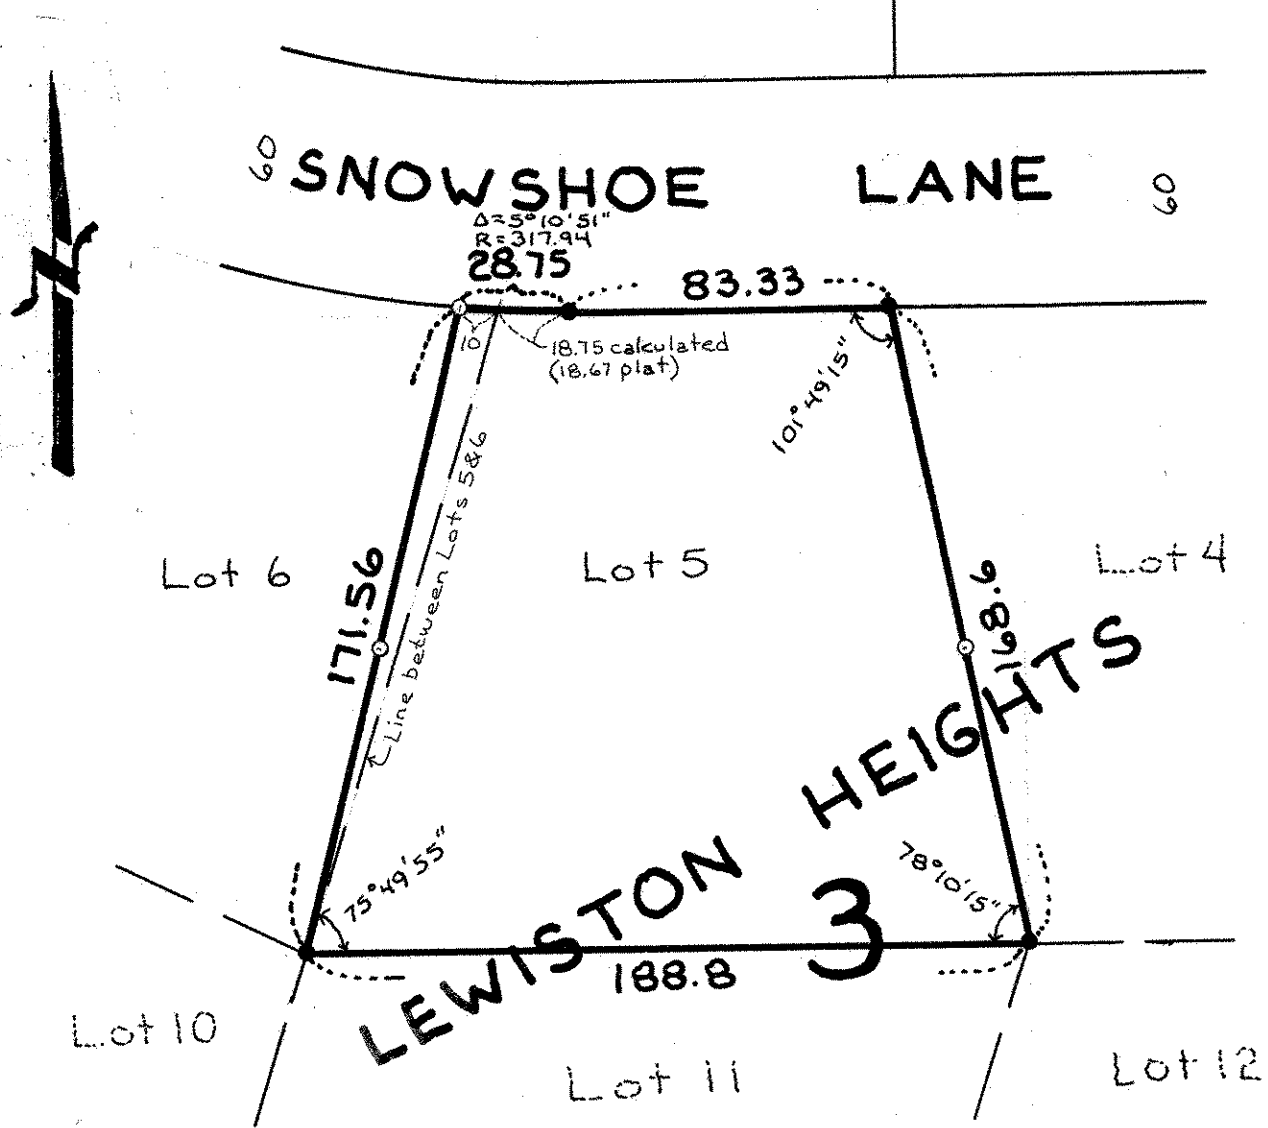

I hereby certify that this survey, plan plat, preliminary plat or report was prepared by me or under my direct supervision and that I am a duly Registered Land Surveyor under the laws of the State of Minnesota.

_____ 10459 _____ R-91788 _____ 5/17/91
 Reg. No. Date Job No. Book No.