

GOMSTOCK AND DAVIS INC.


3092 N. LEXINGTON AVE. ST. PAUL, MN. 55113 483-4408

SURVEYED FOR: Jeff Rebeschke

DESCRIPTION:

Lots 24 and 25, Block 4, Farrar's Addition, Ramsey County, Minnesota

o-Denotes iron monument set ●-Denotes iron found in place

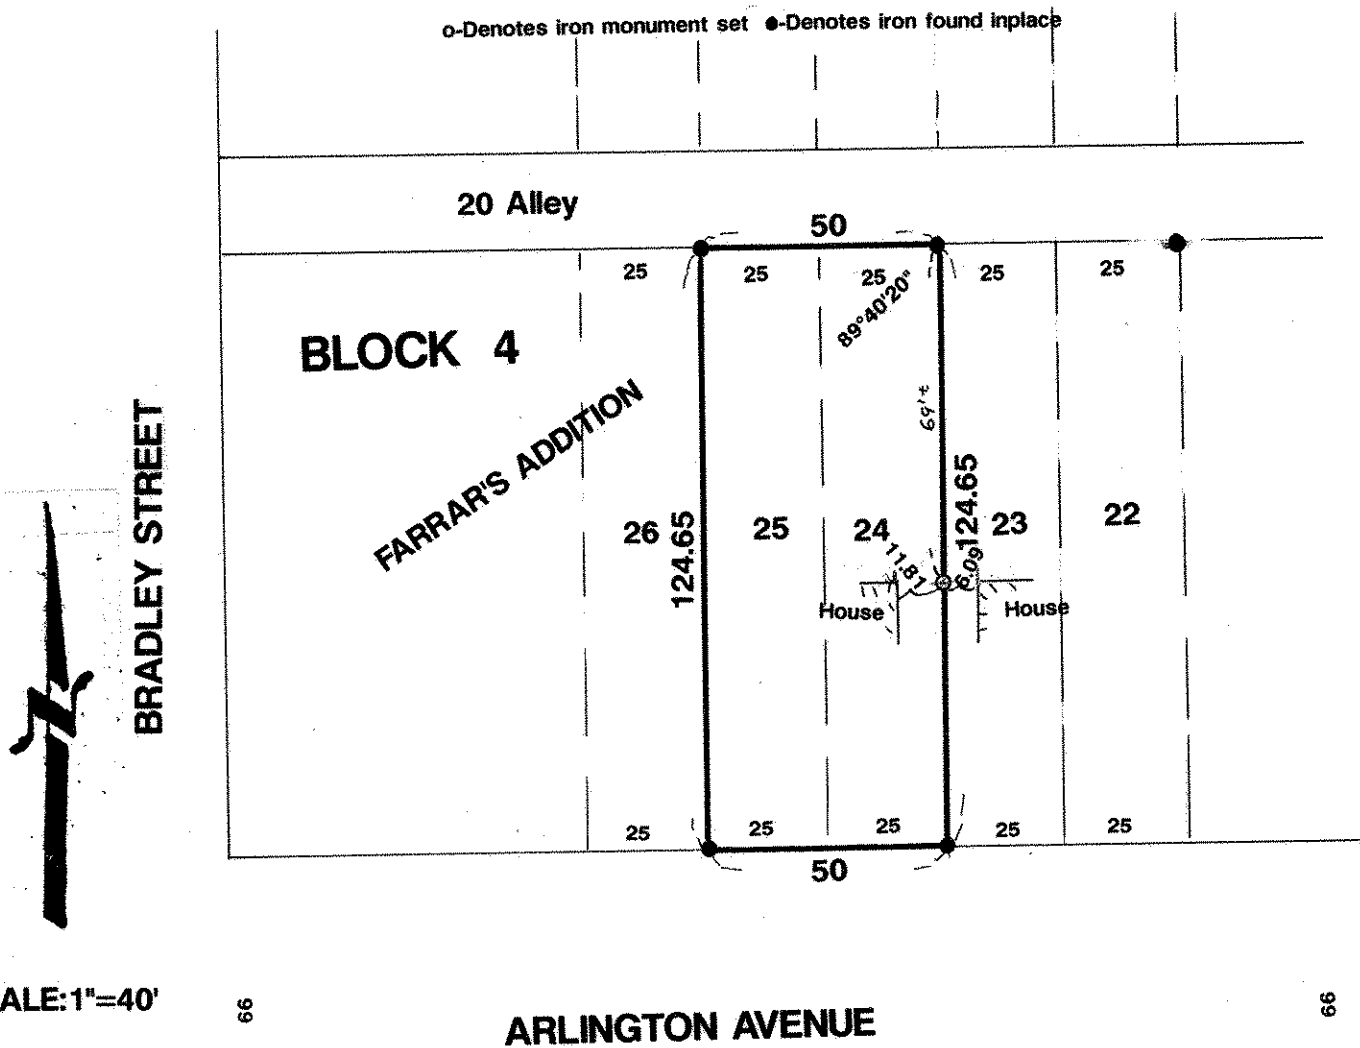

SCALE: 1"=40'

I hereby certify that this survey, plan plat, preliminary plat or report was prepared by me or under my direct supervision and that I am a duly Registered Land Surveyor under the laws of the State of Minnesota

Donald W. Schmitt

10459
Reg. No.

8/26/92
Date

R-92841
Job No.

Book No.