
3092 N. LEXINGTON AVE. ST. PAUL, MN. 55113 SURVEYED FOR: Northern States Agency as per Ty Cross

DESCRIPTION: (Contains 5929 sq.ft.) The North 110 feet of the East half of Lot 79 and all of the North 75 feet of the West half of Lot 79 lying East of the West 44.2 feet thereof, Hewitt's Outlots First Division. Ramsey County, Minnesota

UNIVERSITY AVE.

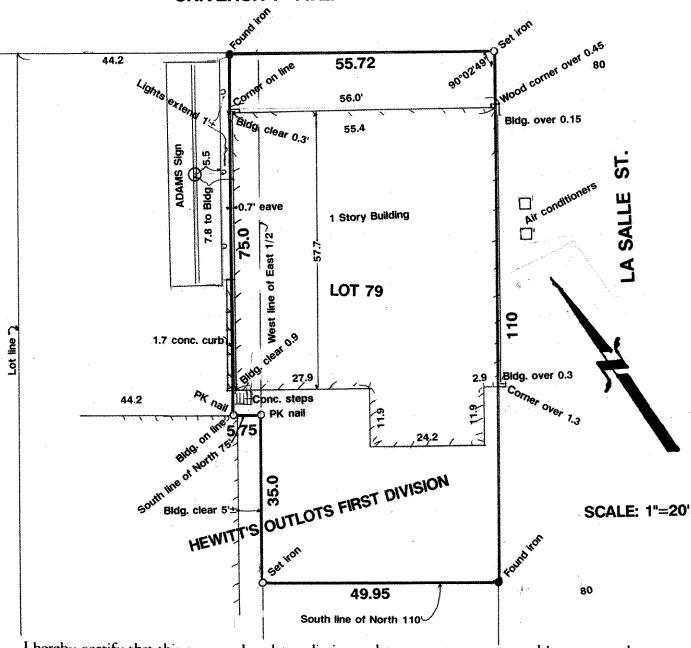

I hereby certify that this survey, plan plat, preliminary plat or report was prepared by me or under my direct supervision and that I am a duly Registered Land Surveyor under the laws of the State

of Minnesota. lDW. Schwielt

10459 #/29/92 R-92774
Reg. No. Date Job No.

Book No.