29-22

COMSTOCK AND DAVIS INC.

3092 N. LEXINGTON AVE. ST. PAUL, MN. 55113 483-4408

SURVEYED FOR: CARDINAL HOMEBUILDERS as per Tom Wiener

DESCRIPTION: Lot 6, Block 3, Westwinds, Ramsey County, Minnesota.

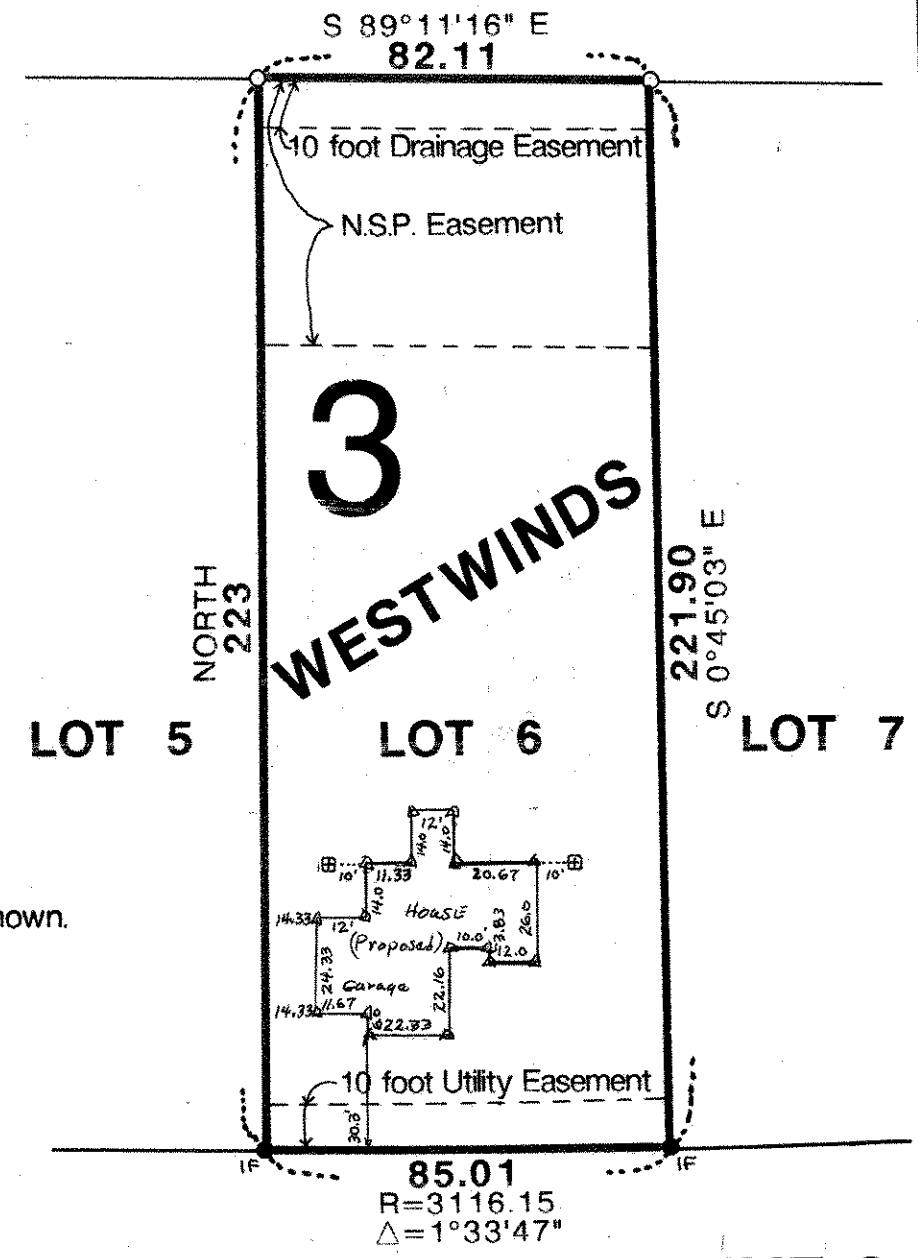

● IF Denotes Iron Pipe found.

○ Denotes Iron Pipe set and marked with Reg. No. 10459.

Easements as per plat only are shown.

SCALE: 1"=40'

⊞ Hub Set on 10'ℰ

△ Hub Set at Building Corner

I hereby certify that this survey, plan plat, preliminary plat or report was prepared by me or under my direct supervision and that I am a duly Registered Land Surveyor under the laws of the State of Minnesota.

10459	6/17/92	R-92804	
Reg. No.	Date	Job No.	Book No.