


GOMSTOCK AND DAVIS INC.

SURVEYED FOR: Richard Sykes

See attached 8 1/2"x11" Certificate for Descriptions

SAVAGE LAKE

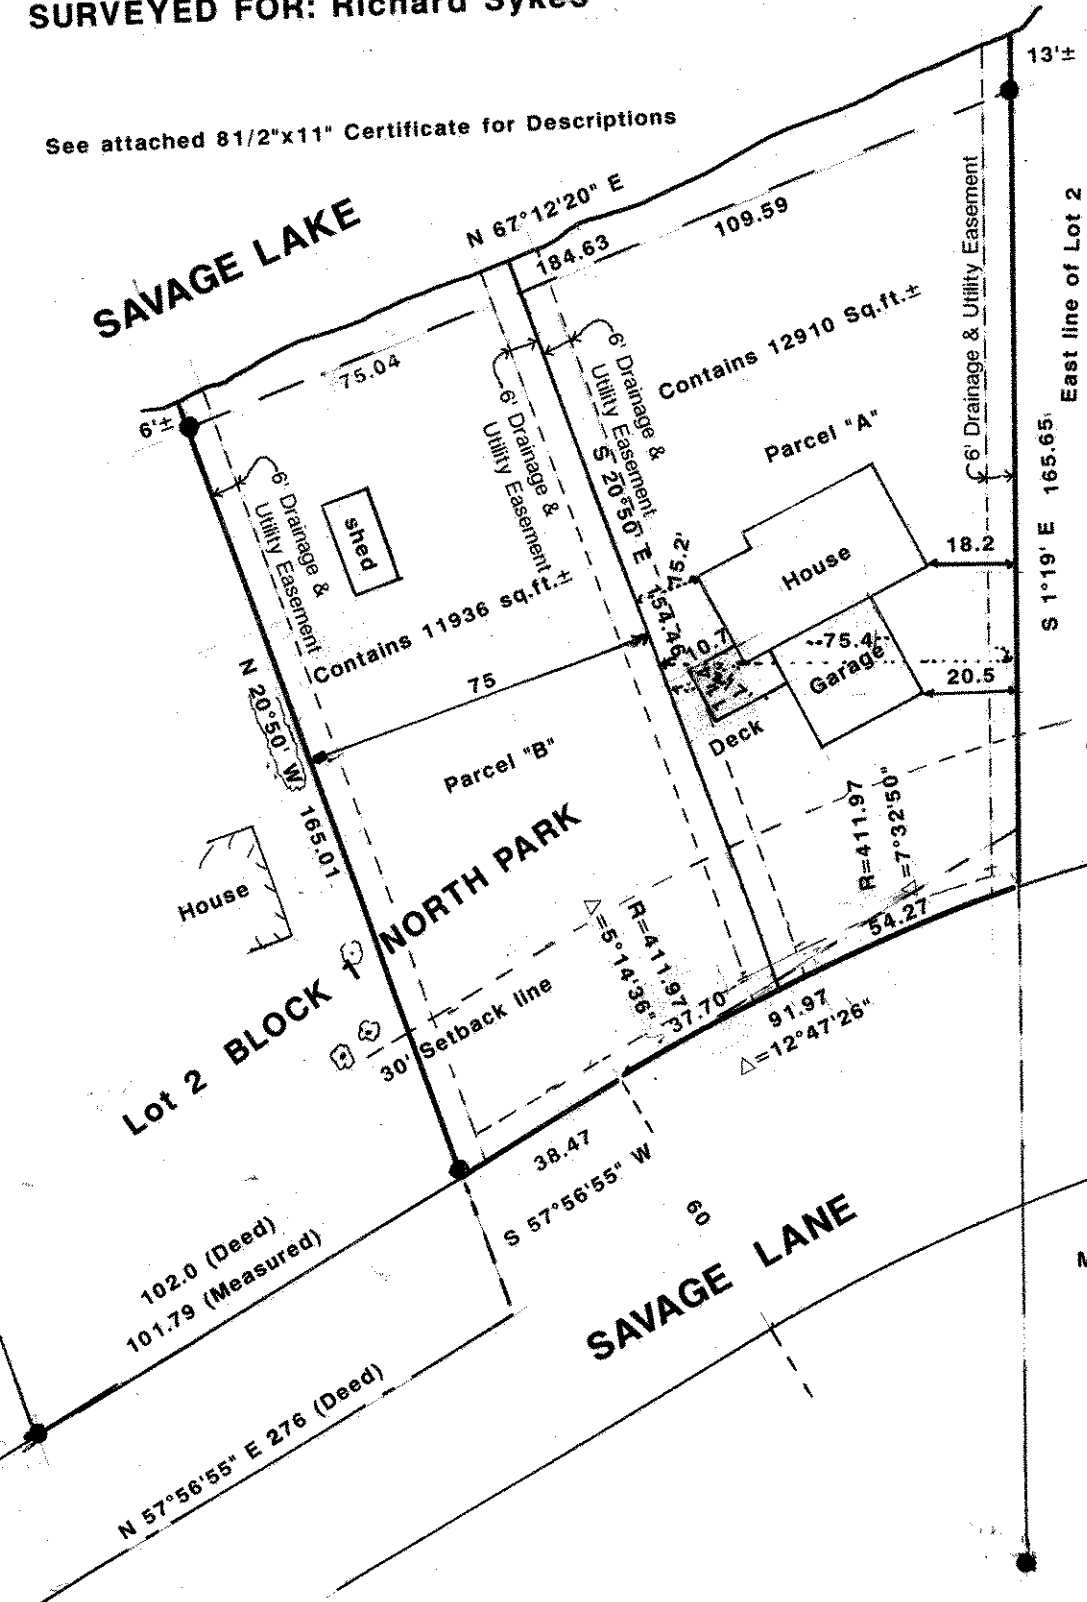

SCALE: 1"=40'

● Denotes iron found in place

- Min. Requirements. 10000 sq.ft.
- 30' Front Setback
- 10' Side Yard Setback
- 75' Wide at Setback Line

I hereby certify that this survey, plan plat, preliminary plat or report was prepared by me or under my direct supervision and that I am a duly Registered Land Surveyor under the laws of the State of Minnesota.

Donald Schmidt

10459
Reg. No.

Revised 4/15/92
5/8/92
Date 5/12/92

R-91828
Job No.

Sheet 1 of 3
Book No.