


CERTIFICATE OF SURVEY FOR: PAUL AND BARB KELEHER

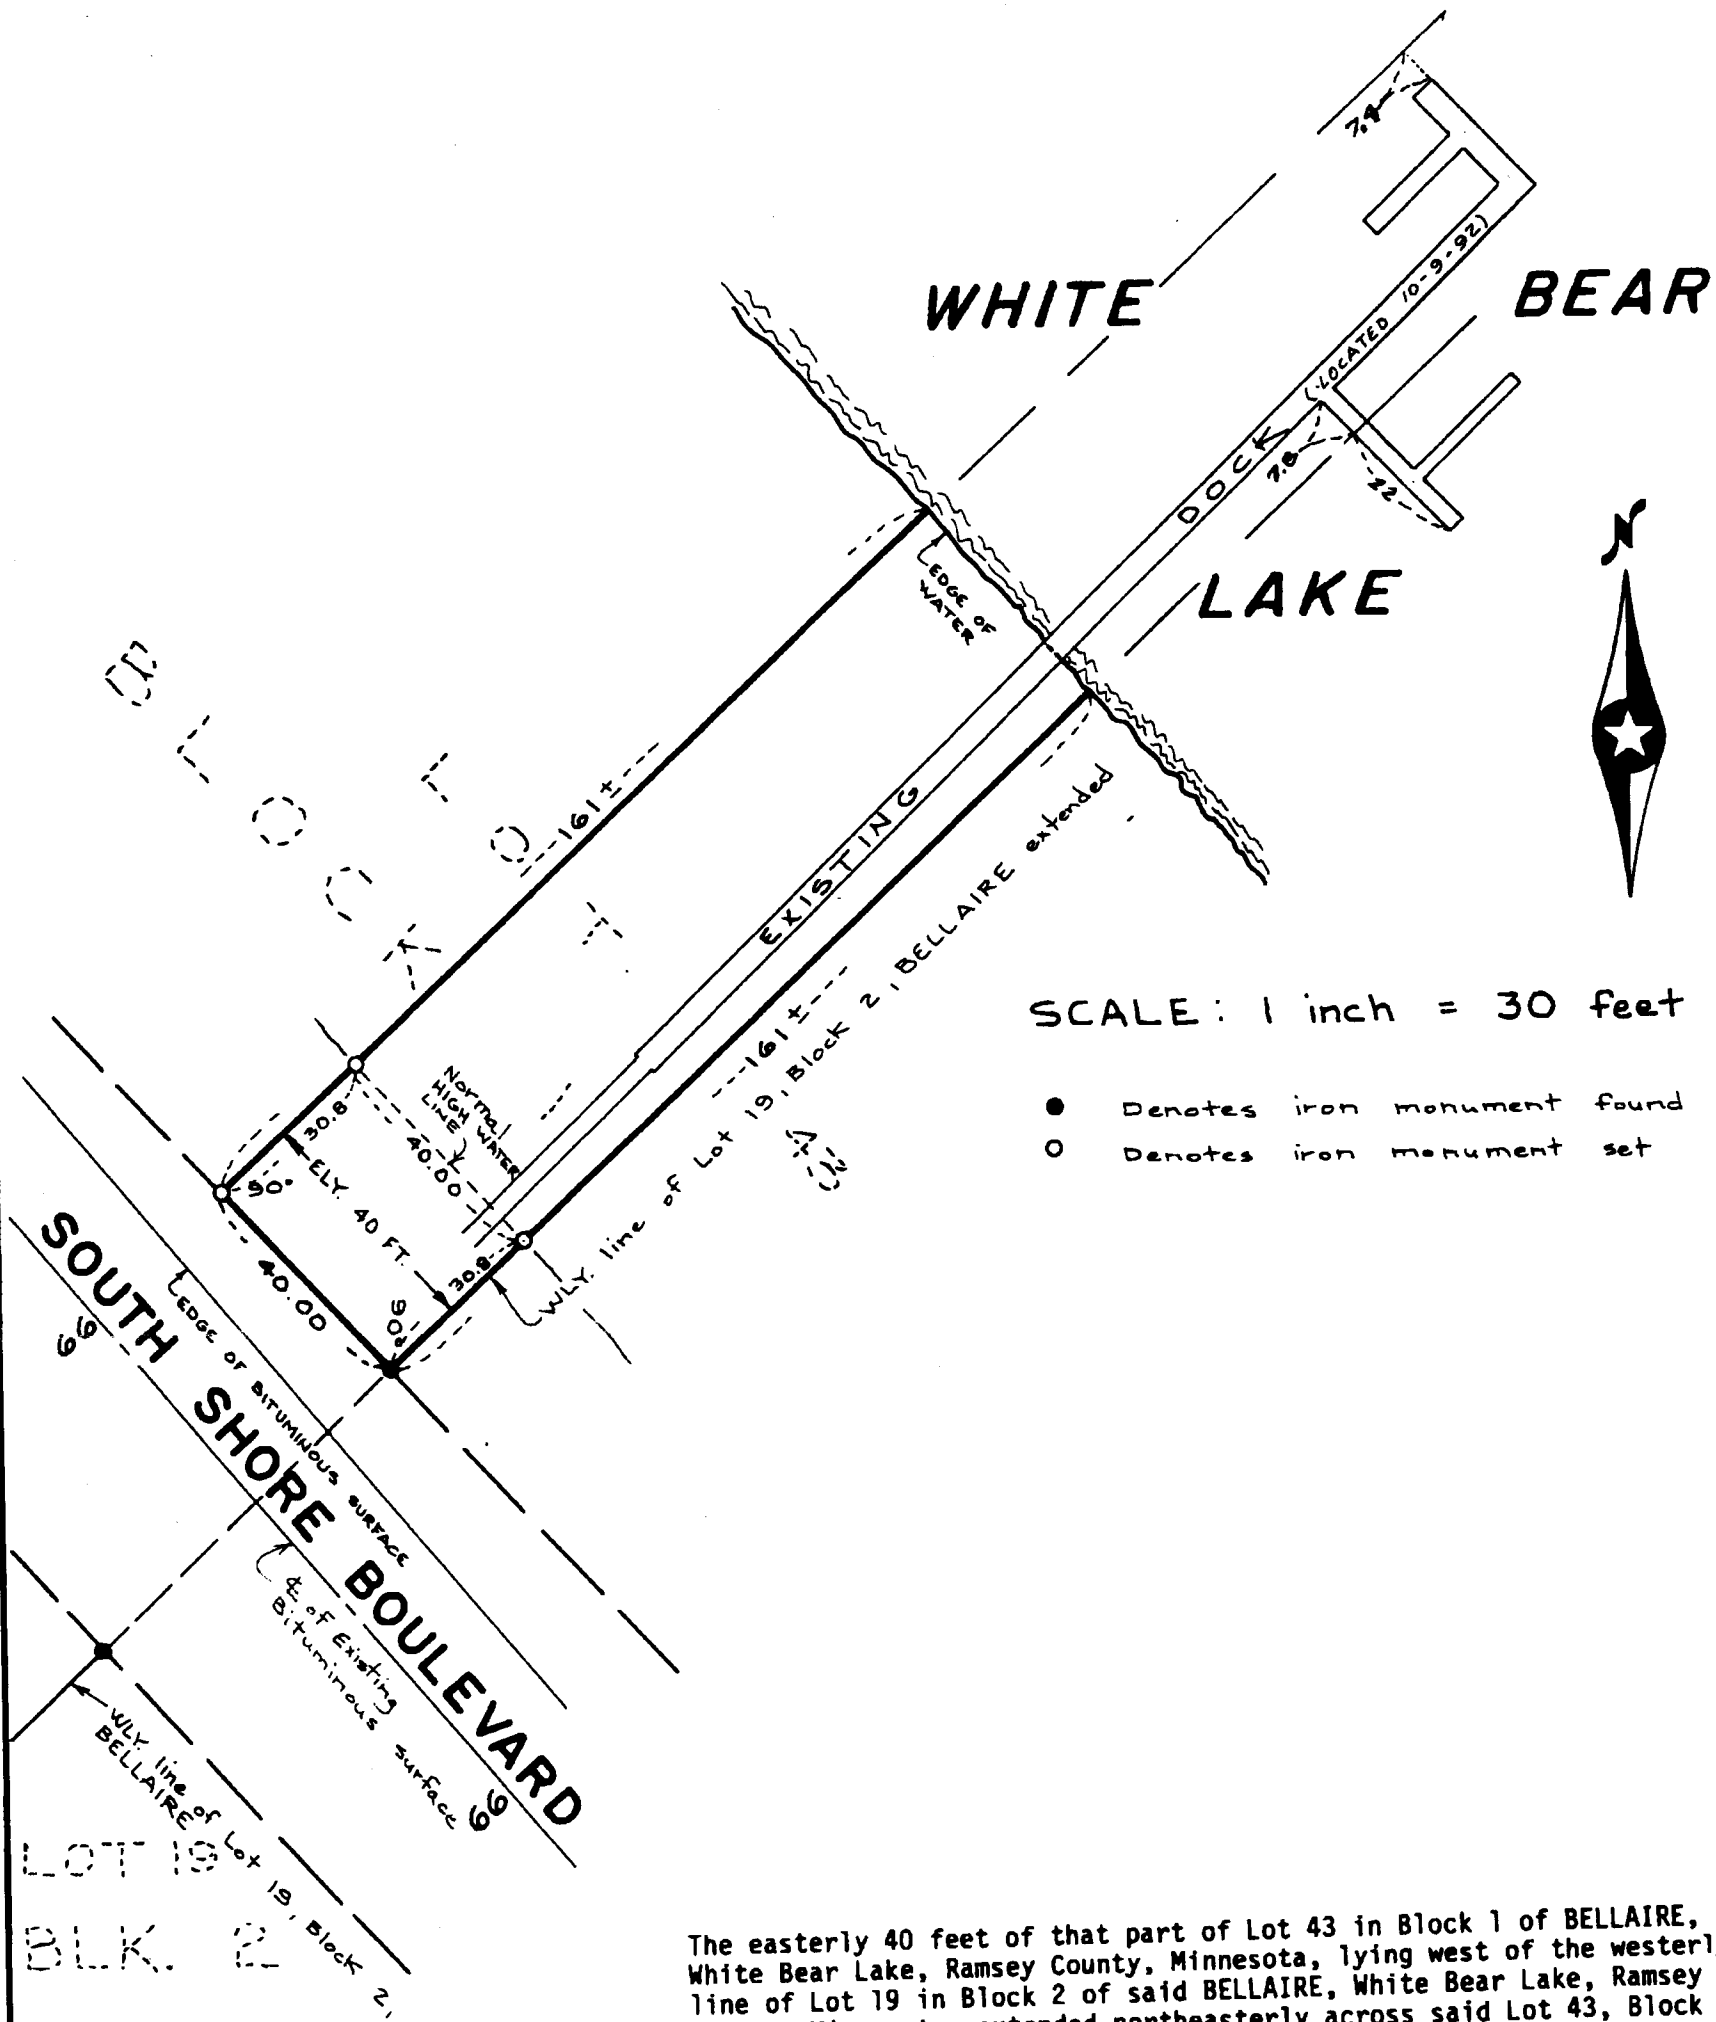

SCALE: 1 inch = 30 feet

- Denotes iron monument found
- Denotes iron monument set

The easterly 40 feet of that part of Lot 43 in Block 1 of BELLAIRE, White Bear Lake, Ramsey County, Minnesota, lying west of the westerly line of Lot 19 in Block 2 of said BELLAIRE, White Bear Lake, Ramsey County, Minnesota, extended northeasterly across said Lot 43, Block 1 of BELLAIRE, White Bear Lake, Ramsey County, Minnesota, all according to the plat thereof on file and of record in the office of the Register of Deeds in and for said Ramsey County, Minnesota.

CARLEY

CARLEY - TORGERSEN, INC.

LAND SURVEYORS

(612) 484-3301

SUITE 703

70 WEST COUNTY ROAD "C"

LITTLE CANADA, MN 55117

TORGERSEN, INC.

Land Surveyors

I hereby certify that this survey, plan or report was prepared by me or under my direct supervision and that I am a duly Registered Land Surveyor under the laws of the State of Minnesota.

Minn. Reg. No. 17551 Date 10-16-92