COMSTOCK AND DAVIS INC.

3092 N. LEXINGTON AVE. ST. PAUL, MN. 55113 483-4408

SURVEYED FOR: FRANK FRATTALONE

DESCRIPTION: Lot 3, Block 1, Kohlman Lake Overlook No. 2, Ramsey County, Minnesota.

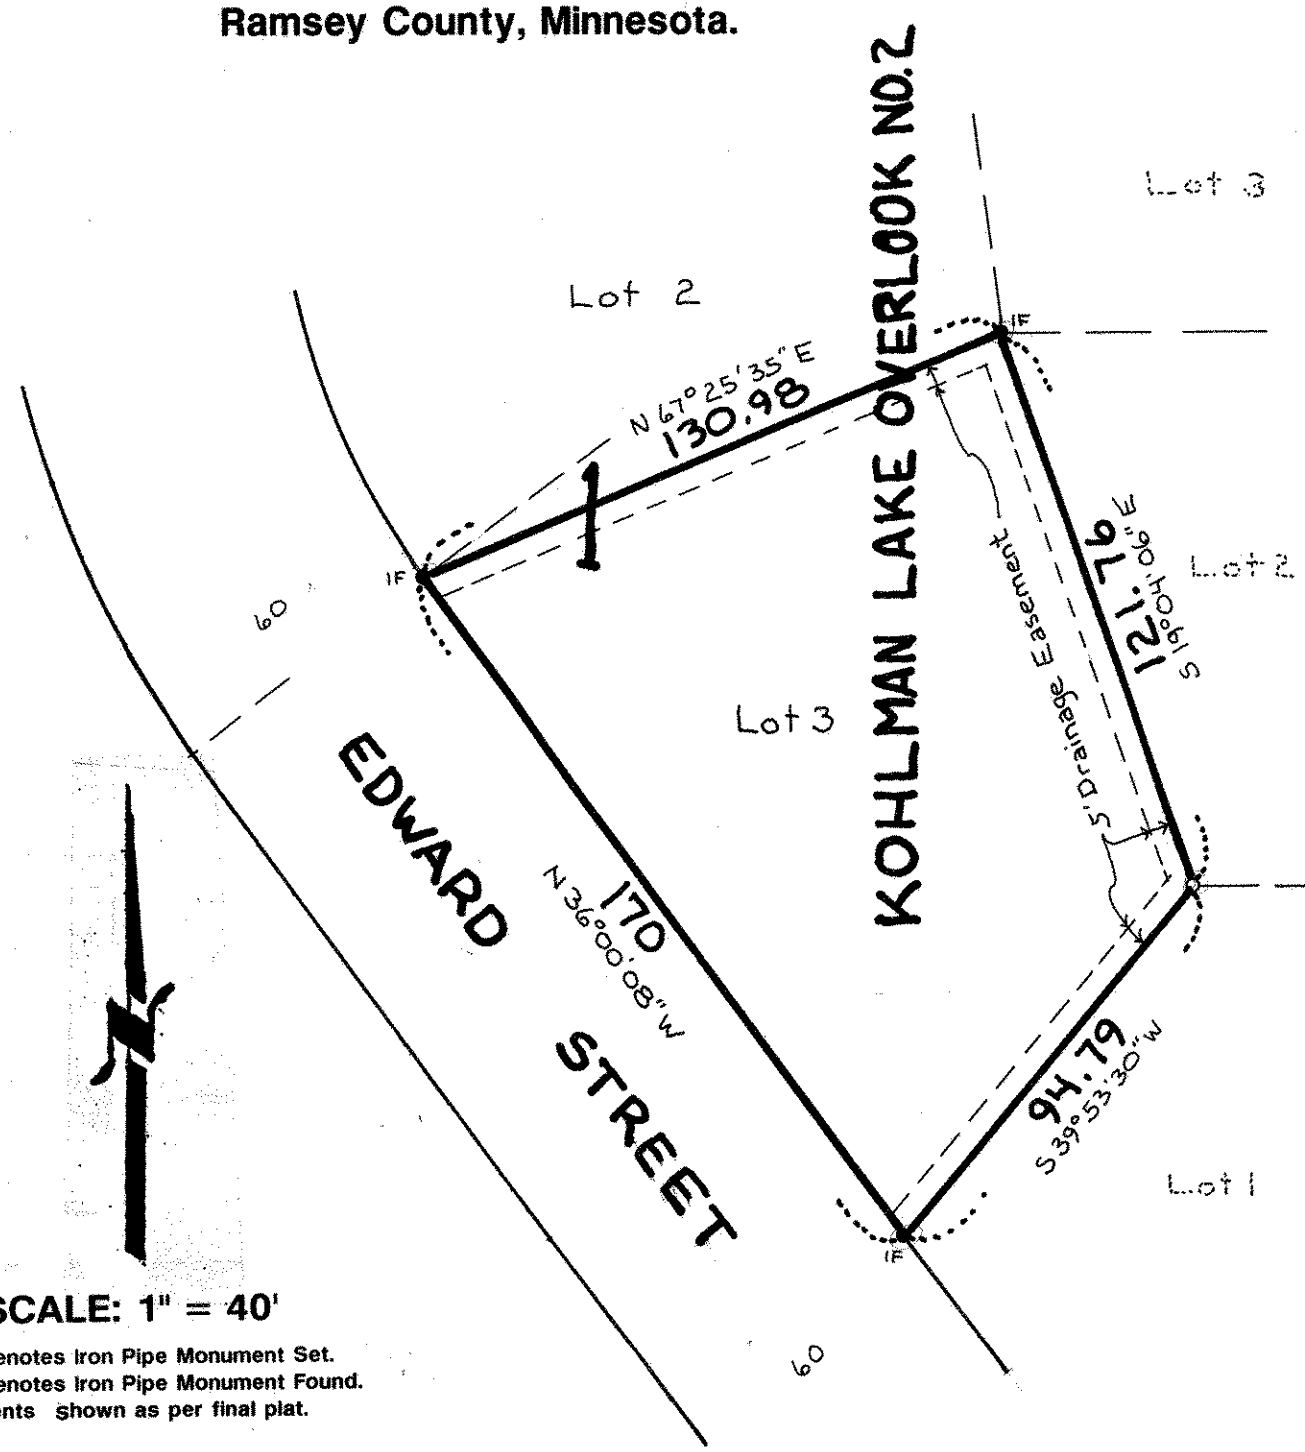

SCALE: 1" = 40'

O Denotes Iron Pipe Monument Set.
IF ● Denotes Iron Pipe Monument Found.
Easements shown as per final plat.

I hereby certify that this survey, plan plat, preliminary plat or report was prepared by me or under my direct supervision and that I am a duly Registered Land Surveyor under the laws of the State of Minnesota.

Donald W. Schmidt	10459	5/21/93	931296	
	Reg. No.	Date	Job No.	Book No.