


GOMSTOCK AND DAVIS INC.

SURVEYED FOR: Orville Erikson

DESCRIPTION: Lot 1, Block 1, Sunrise Park. Ramsey County, Minnesota

- o - Denotes iron pipe monument set
- - Denotes iron found in place

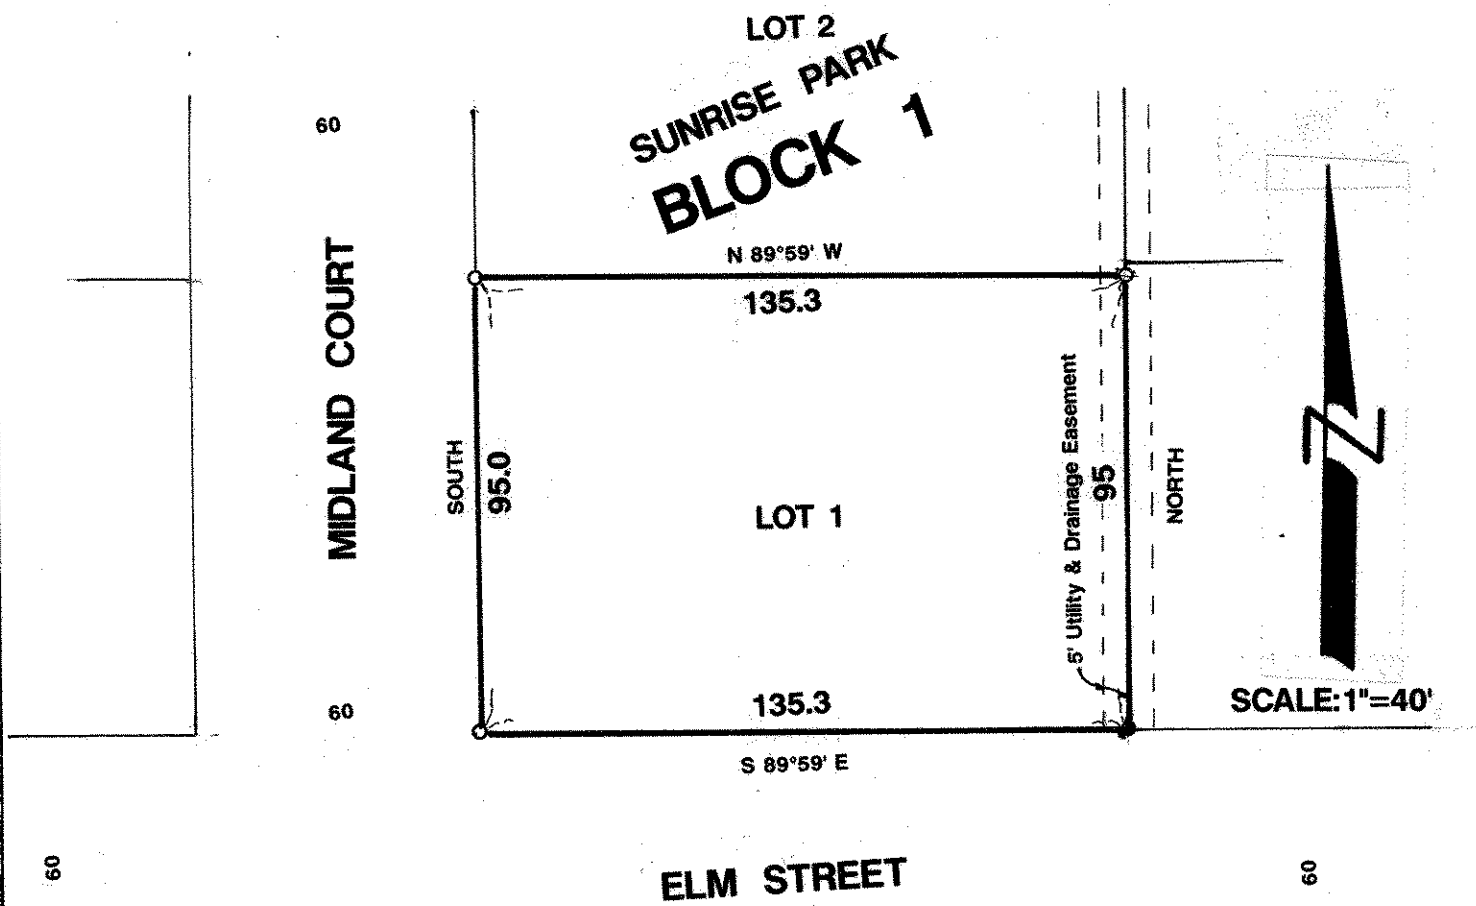

I hereby certify that this survey, plan plat, preliminary plat or report was prepared by me or under my direct supervision and that I am a duly Registered Land Surveyor under the laws of the State of Minnesota.

D. A. Schmitt

Reg. No. 10459 Date 10/5/93 Job No. 930578 Book No. _____